


1ST FLOOR FRAMING PLAN - NORTH

SCALE 1/8"=1'-0"

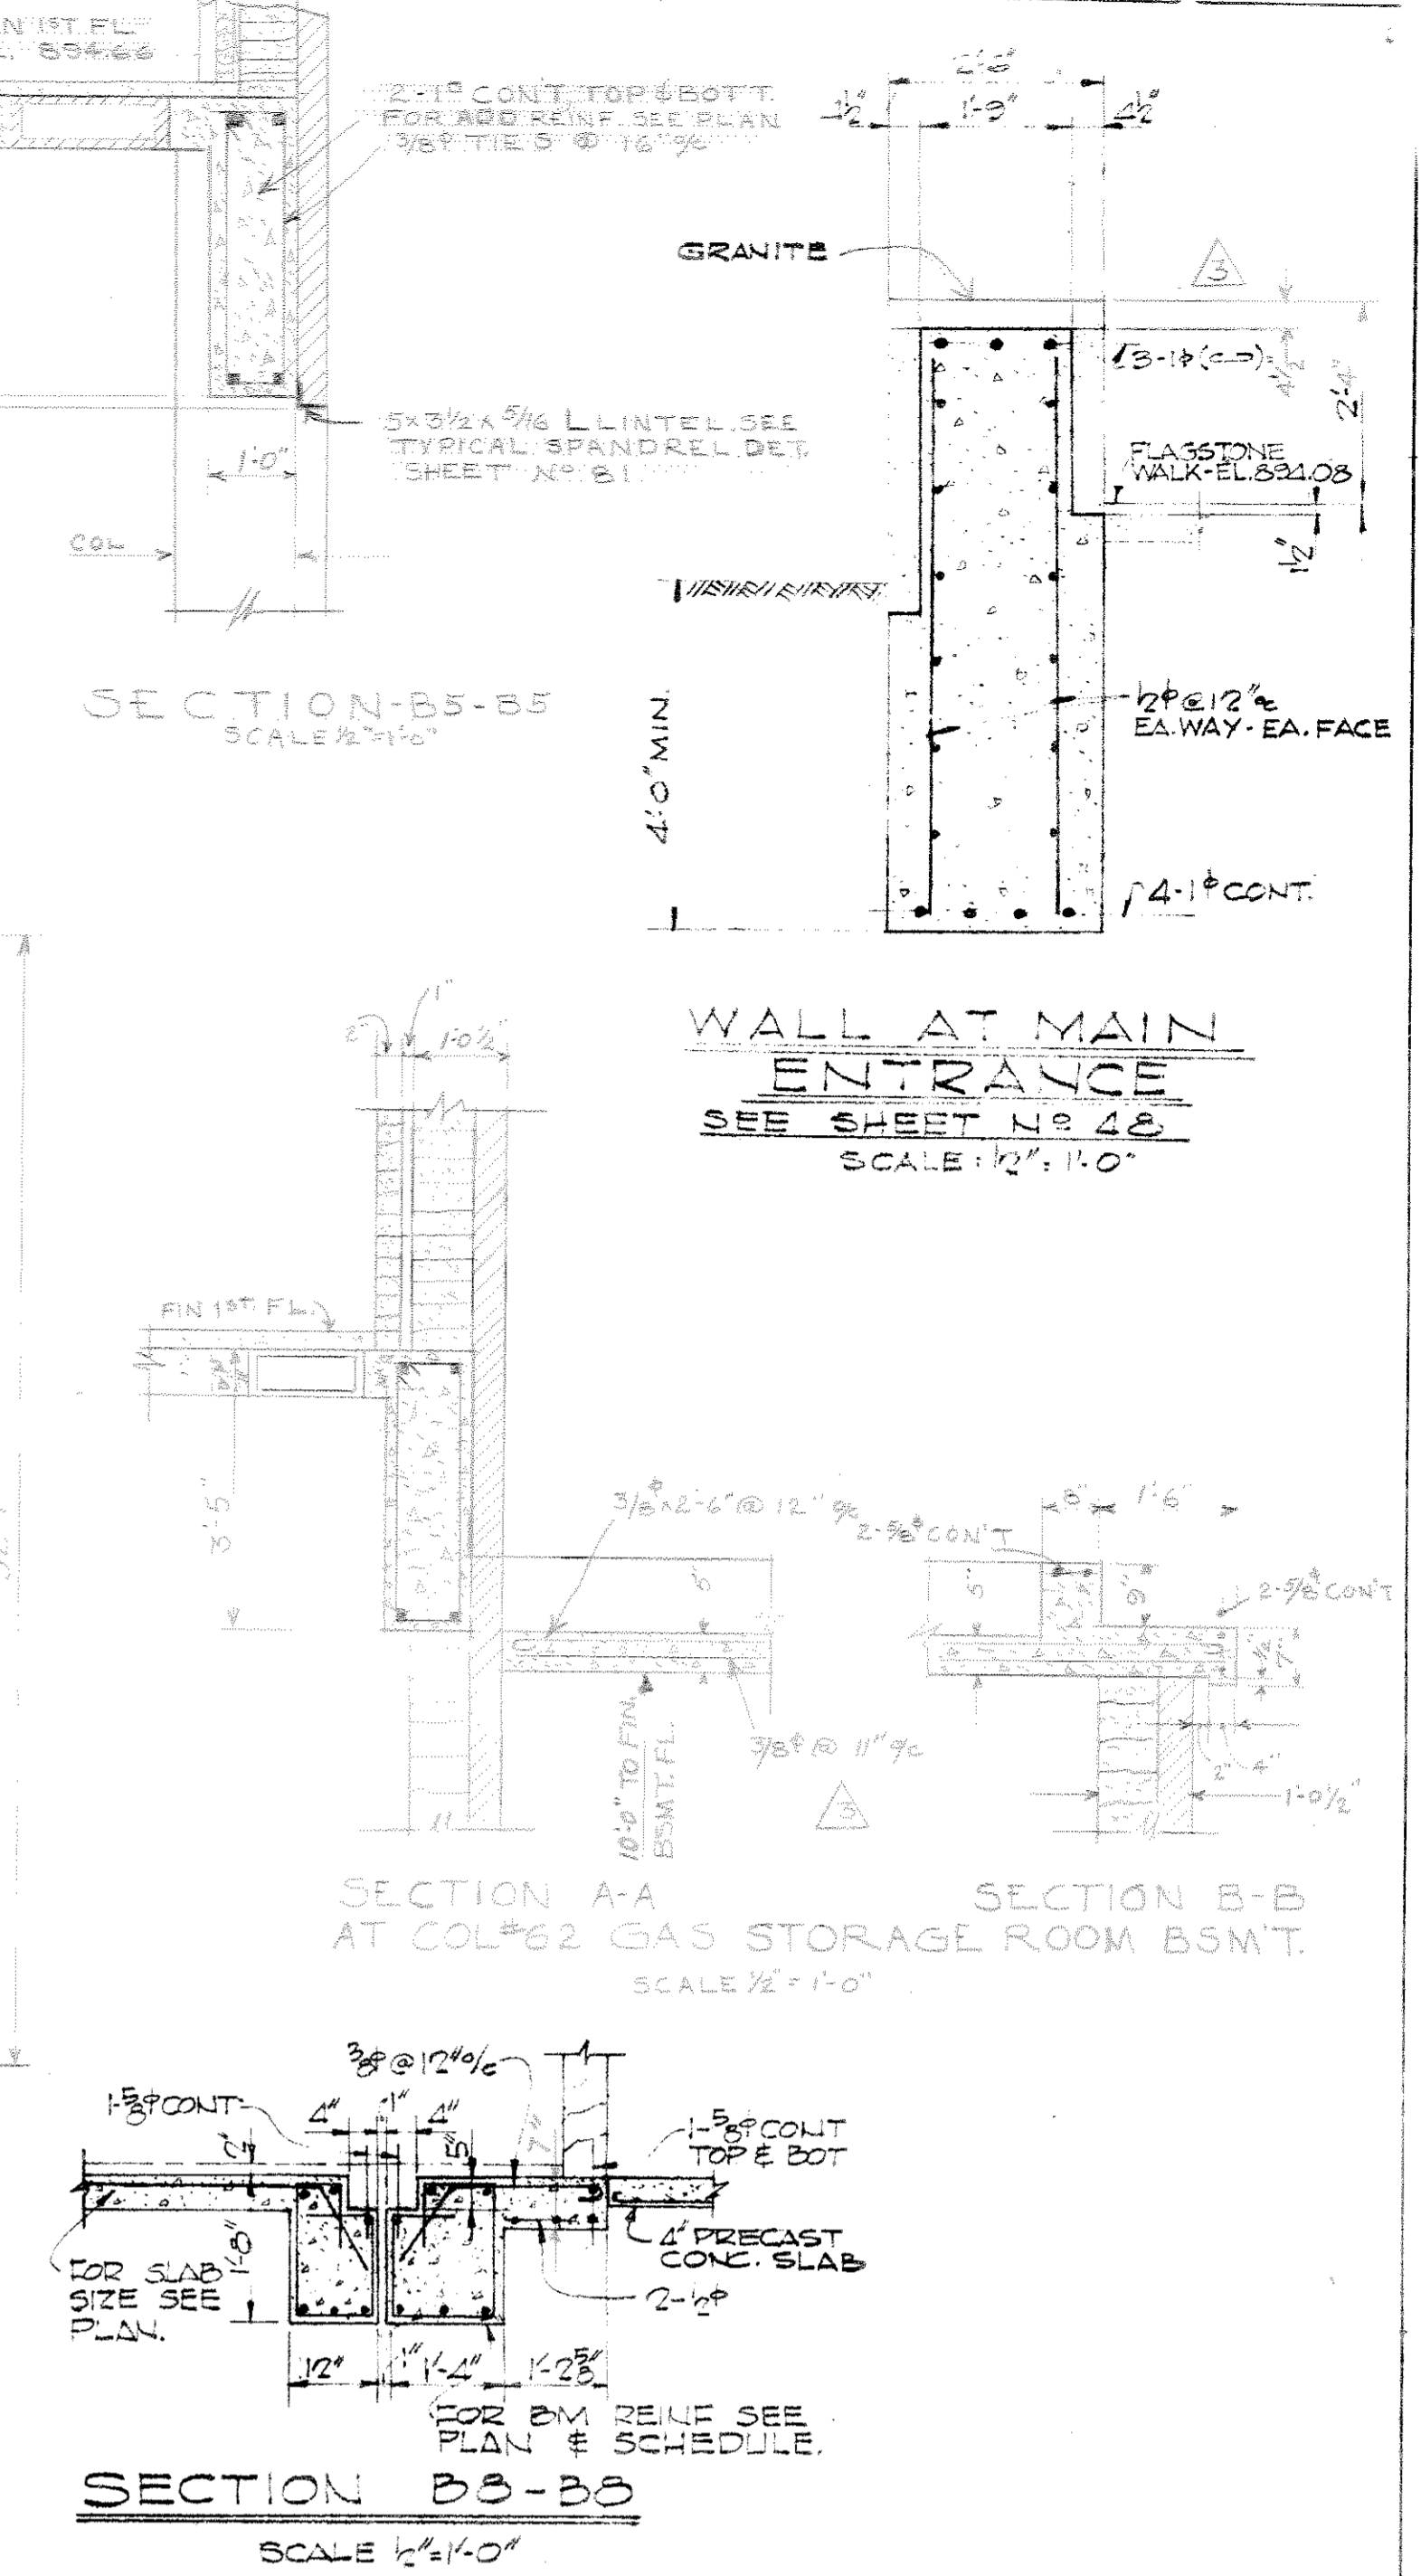


SECTION B5-B5


WALL AT MAIN ENTRANCE

SECTION A-A


SECTION B-B

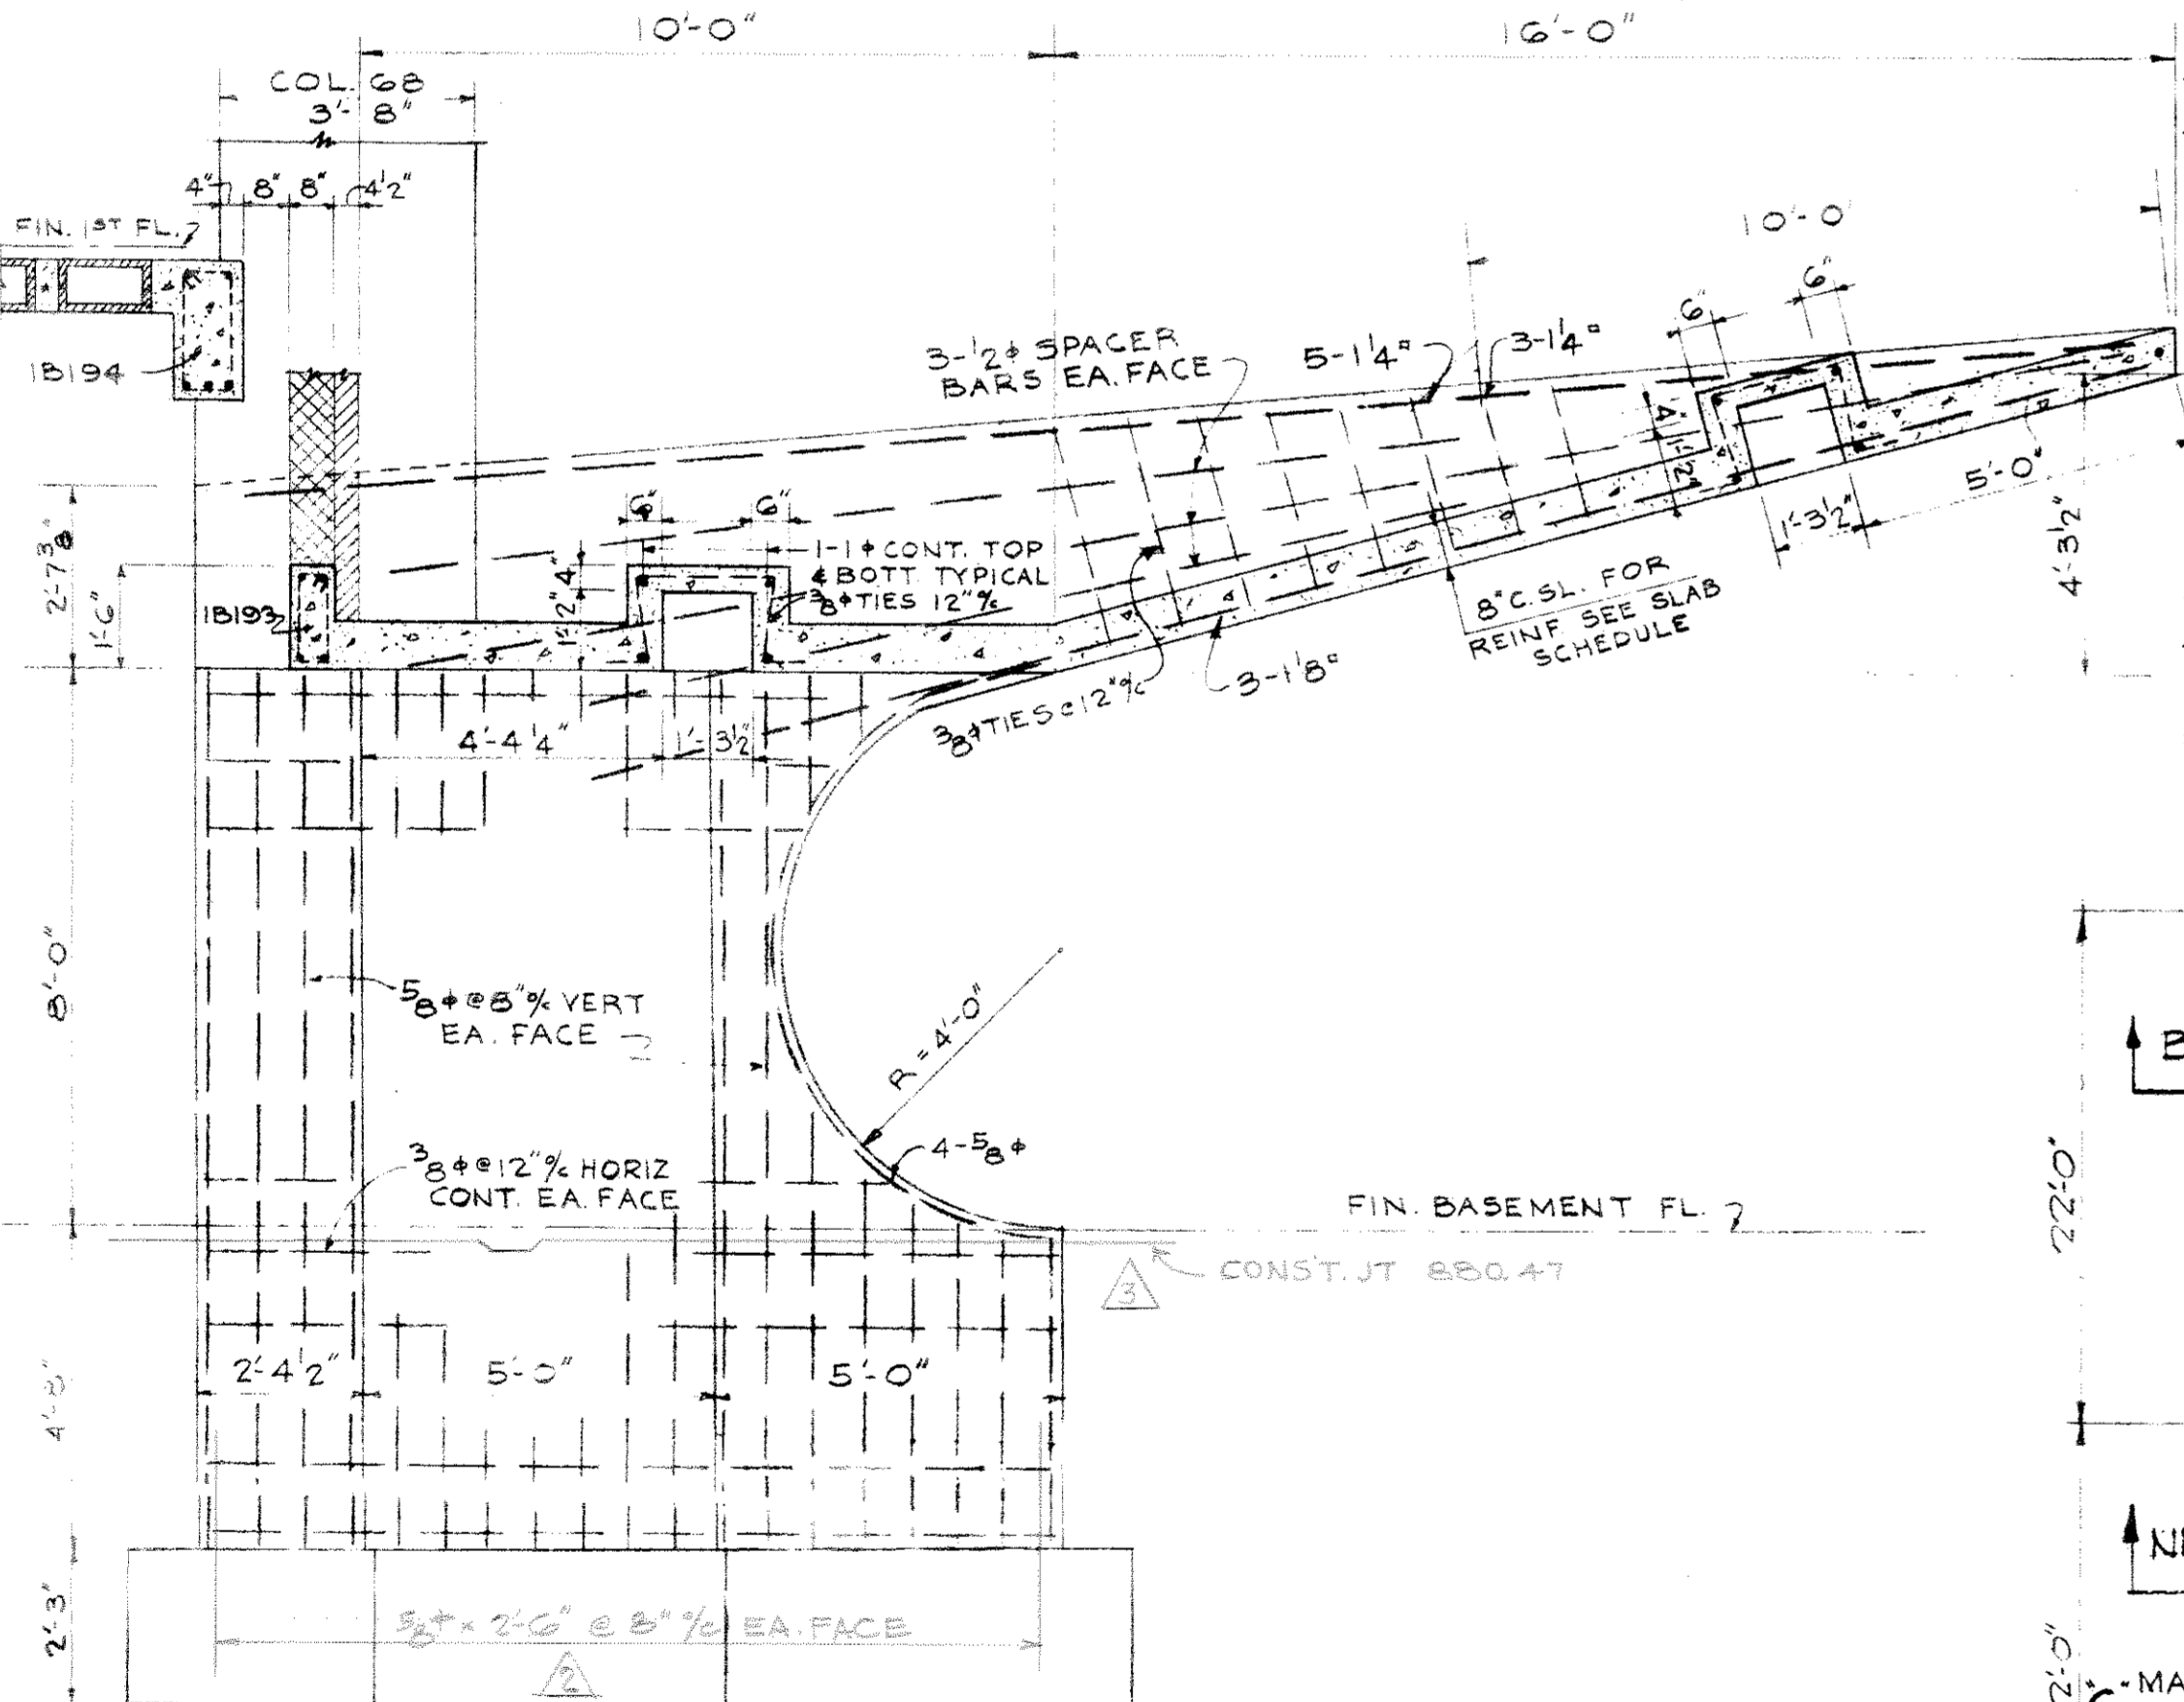


SECTION B6-B6

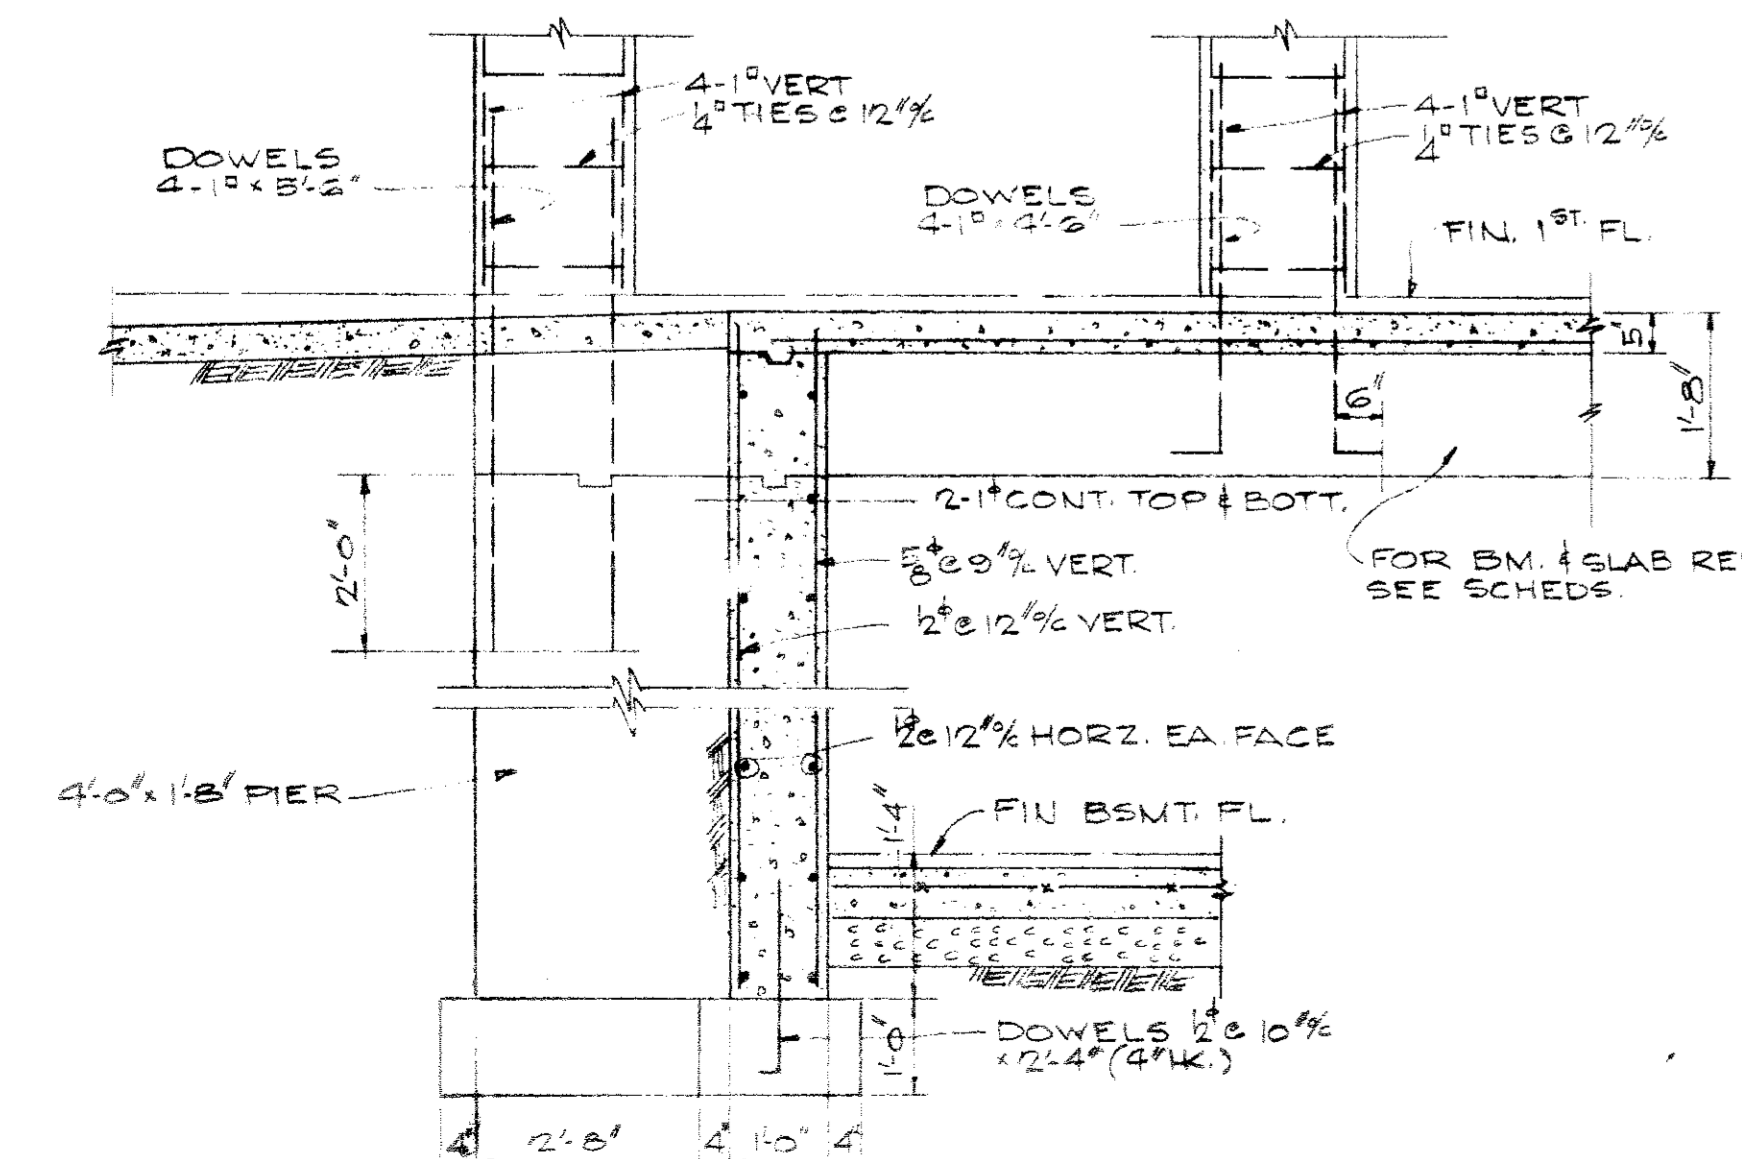

SECTION B7-B7

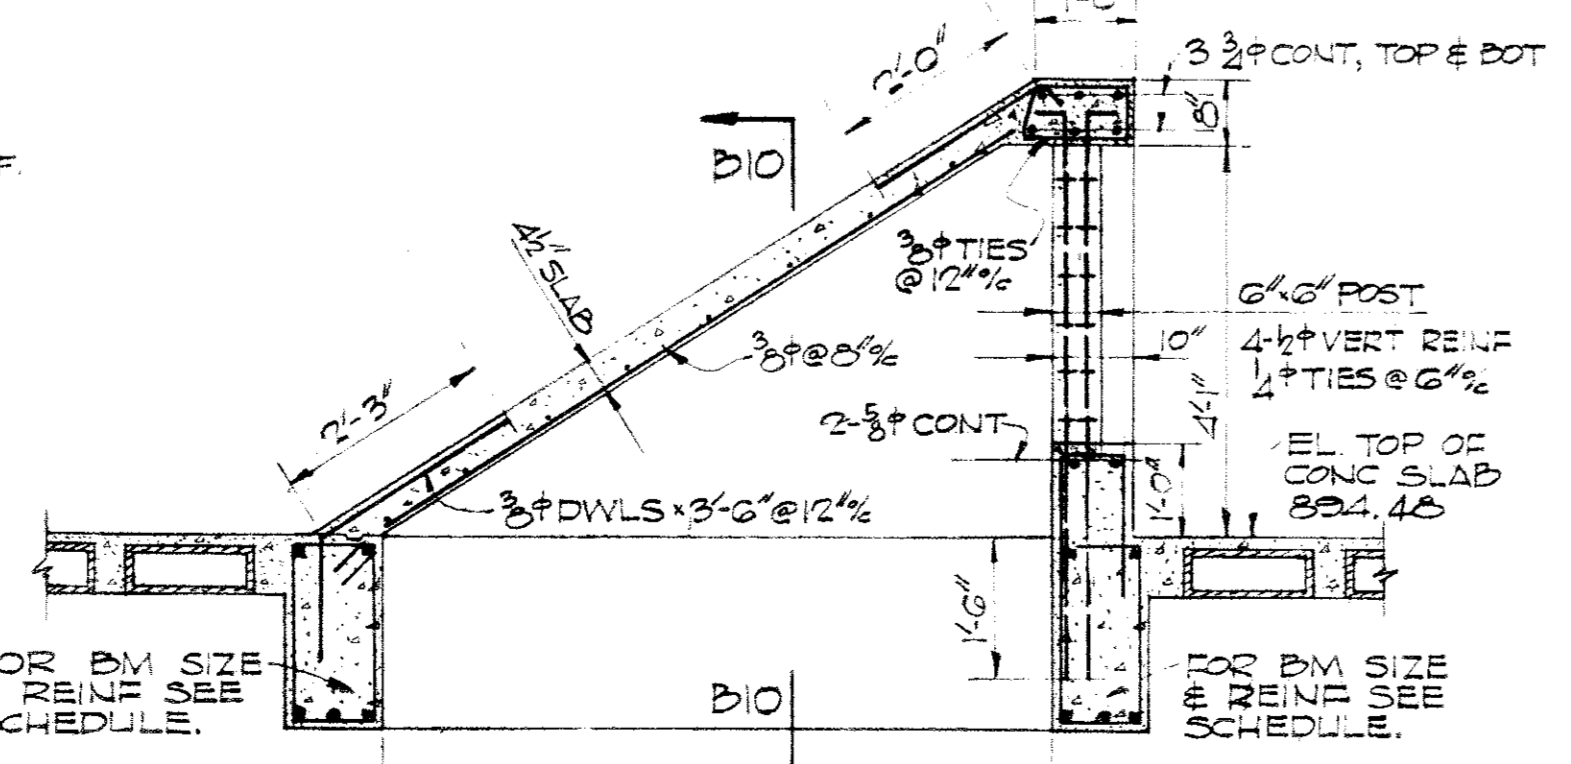

SECTION B9-B9 THRU SKYLIGHT

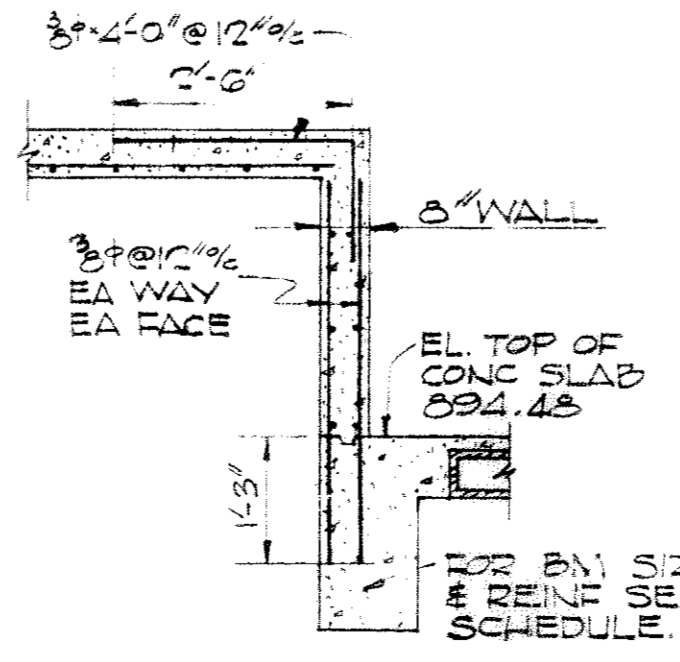

SECTION B10-B10 TYPICAL WALL AT END OF SKYLIGHTS

NOTES

1. FOR TYPICAL DETAILS & GENERAL NOTES SEE SHEET NO. 51.

2. BOB SECTION AS SHOWN SHEET NO. 99. SECTION B4 - SHEET NO. 54, SECTION B7 - SHEET NO. 52.

GRAPHIC SCALES

AS CONSTRUCTED - SEE INDEX	SA
REVISION DATE DESCRIPTION	BY
KELLY & GRUZEN ARCHITECTS - ENGINEERS 220 BROADWAY NEW YORK, N.Y. WAR DEPARTMENT CORPS OF ENGINEERS SYRACUSE DISTRICT SYRACUSE, N.Y. <b>VETERANS ADMINISTRATION WILKES BARRE, PA.</b> 475 BED G. M. <b>1ST FLOOR FRAMING PLAN - NORTH</b>	
DRAWN BY: C.S. # W.G. CHECKED BY: E.M. APPROVED BY: A.J.P. SUBMITTED: Paul A. Kelly APPROVED: [Signature]	STRUCTURAL SCALE AS SHOWN DRAWING NUMBER: 32-01-04 V. A. PROJECT No. 2462 SERIAL NO. W. 20-020-ENR-45-101 DATE 10-18-1947 SHEET 55 OF 164