# Monroe County Historical Association Alteration & Heritage Center Addition 900 Main Street, Stroudsburg, PA 18360

This Addendum forms part of the Contract Documents and modifies the original Bidding documents dated February 16, 2023 as noted below. Acknowledge receipt of this Addendum by inserting its number and date in the space provided on the Bid Form. Failure to do so may subject Bidder to disqualification. This addendum consists of twenty seven (27) page(s) and attachments as listed.

#### I. CHANGES TO THE PREVIOUS ADDENDA

N/A

#### II. GENERAL INFORMATION

Excavated Materials Disposal Site – An approved site is available for soil disposal less than 8 miles from the Stroud Mansion in Middle Smithfield Township, known as Dunbar Enterprises Inc. Stockpile Area. This site will be for soil only and will be optional.

## III. CHANGES TO BIDDING REQUIREMENTS

N/A

#### V. CHANGES TO THE SPECIFICATIONS

Section 12 2413 ROLLER WINDOW SHADES, newly issued section is attached.

Section 28 2310 CCTV SYSTEM (CONSTRUCTION PHASE), added a performance based

specification for construction CCTV cameras

#### VI. CHANGES TO THE DRAWINGS

- A101 ADD notes, dimensions and detail 3/A101 to clarify entrance pavement thickness and landscape planter, natural stone wall construction.
- A103 ADD freestanding stainless steel sink to Room 317 Cleaning
- A500-A503 MODIFY Room Finish Schedule Legend to include "Roller Shade (RS)".

  MODIFY Finish Plans to indicate locations of RS-1
- P103 ADD water piping to service sink in Cleaning 317.
- P202 ADD sanitary piping to service sink in Cleaning 317.
- P203 ADD sanitary piping to service sink in Cleaning 317.
- P500 MODIFIED Riser Diagrams.
- P600 MODIFIED plumbing fixture schedule.
- E100 ADD note about cutting and patching of sidewalk.
- E103 ADD (10) receptacles and wiring in Open Office Area 314.
- E201 ADD track lighting, power wiring and controls in Community Room 111.

  ADD Exterior Lighting Control Diagram.
- E600 ADD circuits for additional receptacles and track lighting to panel schedules.

Addendum No. 2 00990-1 of 3 MCHA – Stroud Mansion Heritage Center Expansion Project MKSD Project No. 16.200

#### VII. RFI QUESTIONS ('Q') AND ANSWERS ('A')

- a) **Q:** Would the owner consider waiving the requirement for AISC certification for structural and misc. steel?
  - A: Steel fabricator is required to be AISC certified, however the owner reserves the right to waive certification requirement in the future.
- b) **Q:** Per addendum 1, div. 09 is to complete finish coats of spackle and plaster, as applicable. How should we quantify this scope of work?
  - A: Refer to Addendum 1 General Information for description of work. GC to coordinate and reference the MPE drawings for scoping, locations, and quantities of cut required for MPE systems.
- c) **Q:** Please confirm that asbestos abatement is within scope of work for this contract as specifications provide contradictory information.
  - A: Yes, asbestos abatement is in project scope. Refer to Addendum 1 D101/D102 revisions.
- d) Q: Substitution Request Seeking approval to bid Pella Lifestyle or Reserve series wood/aluminum clad windows. BOD is Andersen 400 Woodwright A: Pella Reserve is an acceptable substitution.
- e) **Q:** Note 17 on the Electrical drawings, refers to an exterior lighting control diagram. There doesn't appear to be the referenced diagram on the drawings. Please advise.
  - A: Refer to attached revised sheet E201.
- f) Q: Please advise regarding the planter wall and cap detail, specific to materials and construction.
  - A: Refer to attached revised sheet A101.

**ATTACHMENTS** – The following are attached hereto and made a part of the contract documents: Minutes:

N/A

# **Specifications:**

**SECTION 12 2413 ROLLER WINDOW SHADES** 

SECTION 28 2310 CCTV System (Construction Phase)

#### Sketches:

N/A

#### **Drawings:**

A101 – Rev 02.16.23

A103 – Rev 02.16.23

A500 – Rev 02.16.23

A501 - Rev 02.16.23

A502 – Rev 02.16.23

A503 – Rev 02.16.23 P103 - Rev 02.16.23

P202 - Rev 02.16.23

P203 - Rev 02.16.23

P500 - Rev 02.16.23

Addendum No. 2 MCHA – Stroud Mansion Heritage Center Expansion Project MKSD Project No. 16.200 P600 - Rev 02.16.23

E100 - Rev 02.16.23

E103 - Rev 02.16.23

E201 – Rev 02.16.23

E600 – Rev 02.16.23

# **END OF ADDENDUM No. 2**

#### SECTION 12 2413 - ROLLER WINDOW SHADES

#### PART 1 - GENERAL

## 1.1 RELATED DOCUMENTS

A. Drawings and general provisions of the Contract, including General and Supplementary Conditions and Division 01 Specification Sections, apply to this Section.

#### 1.2 SUMMARY

- A. Section Includes:
  - 1. Manually operated sunscreen roller shades.
- B. Related Requirements:
  - 1. Division 06 Section "Rough Carpentry" for wood blocking and grounds for mounting roller shades and accessories.

#### 1.3 SUBMITTALS

- A. Product Data: For each type of product.
  - Include styles, material descriptions, construction details, dimensions of individual components and profiles, features, finishes, and operating instructions for roller shades.
- B. Shop Drawings: Show fabrication and installation details for roller shades, including shadeband materials, their orientation to rollers, and their seam and batten locations.
  - 1. Manual-Operated Shades: Include details of installation and relationship to adjacent work.
- C. Samples: For each exposed product and for each color and texture specified, 10 inches long.
- D. Roller-Shade Schedule: Use same designations indicated on Drawings.
- E. Product Certificates: For each type of shadeband material, signed by product manufacturer.
- F. Maintenance Data: For roller shades to include in maintenance manuals.

#### 1.4 QUALITY ASSURANCE

A. Installer Qualifications: Fabricator of products.

# 1.5 DELIVERY, STORAGE, AND HANDLING

A. Deliver roller shades in factory packages, marked with manufacturer, product name, and location of installation using same designations indicated on Drawings.

#### 1.6 FIELD CONDITIONS

- A. Environmental Limitations: Do not install roller shades until construction and finish work in spaces, including painting, is complete and dry and ambient temperature and humidity conditions are maintained at the levels indicated for Project when occupied for its intended use.
- B. Field Measurements: Where roller shades are indicated to fit to other construction, verify dimensions of other construction by field measurements before fabrication and indicate measurements on Shop Drawings. Allow clearances for operating hardware of operable glazed units through entire operating range. Notify Architect of installation conditions that vary from Drawings. Coordinate fabrication schedule with construction progress to avoid delaying the Work.

#### PART 2 - PRODUCTS

## 2.1 MANUFACTURERS

- A. Basis-of-Design Product: Subject to compliance with requirements, provide MechoShade Systems, Inc. or comparable product by one of the following:
  - 1. Draper Inc.
  - 2. Hunter Douglas Contract.
- B. Source Limitations: Obtain roller shades from single source from single manufacturer.

## 2.2 MANUALLY OPERATED SHADES WITH SINGLE ROLLERS

- A. Chain-and-Clutch Operating Mechanisms: With continuous-loop bead chain and clutch that stops shade movement when bead chain is released; permanently adjusted and lubricated.
  - 1. Chain-Retainer Type: Clip, jamb mount
  - 2. Spring Lift-Assist Mechanisms: Provide for shadebands that weigh more than 10 lb (4.5 kg) or for shades as recommended by manufacturer, whichever criterion is more stringent.

- B. Crank-and-Gear Operating Mechanisms: Sealed gearbox drive system controlled by permanently mounted crank handle.
- C. Rollers: Corrosion-resistant steel or extruded-aluminum tubes of diameters and wall thicknesses required to accommodate operating mechanisms and weights and widths of shadebands indicated without deflection. Provide with permanently lubricated driveend assemblies and idle-end assemblies designed to facilitate removal of shadebands for service.
  - 1. Roller Drive-End Location: Right side of interior face of shade
  - 2. Direction of Shadeband Roll: Regular, from back (exterior face) of roller
- D. Mounting Hardware: Brackets or endcaps, corrosion resistant and compatible with roller assembly, operating mechanism, installation accessories, and mounting location and conditions indicated.
- E. Roller-Coupling Assemblies: Coordinated with operating mechanism and designed to join up to three inline rollers into a multiband shade that is operated by one roller driveend assembly.

#### F. Shadebands:

- 1. Shadeband Material: Light-blocking fabric (3% openness)
- 2. Shadeband Bottom (Hem) Bar: Steel or extruded aluminum.
  - a. Type: Exposed with endcaps and integral light seal at bottom where it meets the sill
  - b. Color and Finish: As selected by Architect from manufacturer's full range

## G. Installation Accessories:

- 1. Front Fascia: Aluminum extrusion that conceals front and underside of roller and operating mechanism and attaches to roller endcaps without exposed fasteners.
- 2. Exposed Headbox: Rectangular, extruded-aluminum enclosure including front fascia, top and back covers, endcaps, and removable bottom closure.
- 3. Endcap Covers: To cover exposed endcaps.
- 4. Recessed Shade Pocket: Rectangular, extruded-aluminum enclosure designed for recessed ceiling installation; with front, top, and back formed as one piece, end plates, and removable bottom closure panel.
- 5. Closure Panel and Wall Clip: Removable aluminum panel designed for installation at bottom of site-constructed ceiling recess or pocket and for snap-in attachment to wall clip without fasteners.
- 6. Side Channels: With light seals and designed to eliminate light gaps at sides of shades as shades are drawn down. Provide side channels with shadeband guides or other means of aligning shadebands with channels at tops.
- 7. Bottom (Sill) Channel or Angle: With light seals and designed to eliminate light gaps at bottoms of shades when shades are closed.
- 8. Installation Accessories Color and Finish: As selected from manufacturer's full range

## 2.3 SHADEBAND MATERIALS

- A. Shadeband Material Flame-Resistance Rating: Comply with NFPA 701. Testing by a qualified testing agency. Identify products with appropriate markings of applicable testing agency.
- B. Light-Blocking Fabric: Opaque fabric (3% openness), stain and fade resistant.
  - Source: Roller-shade manufacturer.
  - 2. Type: Acrylic-coated fiberglass.
  - 3. Weight: Minimum 13 oz./sq. yd.>.
  - 4. Roll Width: As required to span window opening.
  - 5. Features: Antistatic treatment.
  - Color: As selected by Architect from manufacturer's full range.

#### 2.4 ROLLER-SHADE FABRICATION

- A. Product Safety Standard: Fabricate roller shades to comply with WCMA A 100.1, including requirements for flexible, chain-loop devices; lead content of components; and warning labels.
- B. Unit Sizes: Fabricate units in sizes to fill window and other openings as follows, measured at 74 deg F:
  - 1. Between (Inside) Jamb Installation: Width equal to jamb-to-jamb dimension of opening in which shade is installed less 1/4 inch per side or 1/2-inch total, plus or minus 1/8 inch. Length equal to head-to-sill or -floor dimension of opening in which shade is installed less 1/4 inch, plus or minus 1/8 inch.
  - 2. Outside of Jamb Installation: Width and length as indicated, with terminations between shades of end-to-end installations at centerlines of mullion or other defined vertical separations between openings.
- C. Shadeband Fabrication: Fabricate shadebands without battens or seams to extent possible except as follows:
  - 1. Vertical Shades: Where width-to-length ratio of shadeband is equal to or greater than 1:4, provide battens and seams at uniform spacings along shadeband length to ensure shadeband tracking and alignment through its full range of movement without distortion of the material.

#### PART 3 - EXECUTION

## 3.1 EXAMINATION

A. Examine substrates, areas, and conditions, with Installer present, for compliance with requirements for installation tolerances, operational clearances, accurate locations of

connections to building electrical system, and other conditions affecting performance of the Work.

B. Proceed with installation only after unsatisfactory conditions have been corrected.

#### 3.2 ROLLER-SHADE INSTALLATION

- A. Install roller shades level, plumb, and aligned with adjacent units according to manufacturer's written instructions.
  - 1. Opaque Shadebands: Located so shadeband is not closer than 2 inches to interior face of glass. Allow clearances for window operation hardware.
- B. Electrical Connections: Connect motor-operated roller shades to building electrical system.

#### 3.3 ADJUSTING

A. Adjust and balance roller shades to operate smoothly, easily, safely, and free from binding or malfunction throughout entire operational range.

## 3.4 CLEANING AND PROTECTION

- A. Clean roller-shade surfaces after installation, according to manufacturer's written instructions.
- B. Provide final protection and maintain conditions, in a manner acceptable to manufacturer and Installer, that ensure that roller shades are without damage or deterioration at time of Substantial Completion.
- C. Replace damaged roller shades that cannot be repaired, in a manner approved by Architect, before time of Substantial Completion.

#### 3.5 DEMONSTRATION

A. Engage a factory-authorized service representative to train Owner's maintenance personnel to adjust, operate, and maintain motor-operated roller shades.

**END OF SECTION 12 2413** 

## SECTION 28 2310 – CCTV SYSTEM (CONSTRUCTION PHASE)

#### PART 1 - GENERAL

#### 1.1 RELATED DOCUMENTS

A. Drawings and general provisions of the Contract, including General and Supplementary Conditions and Division 01 Specification Sections, apply to this Section.

#### 1.2 SUMMARY

A. This Section includes closed circuit television (CCTV) video surveillance systems consisting of cameras, networked video recorder, wiring, and associated equipment. The CCTV system is to be installed during construction related activities at the project site and removed at the completion of construction. The Contractor proposed CCTV system must be reviewed with the design project team and owner prior to ordering any equipment.

#### 1.3 **QUALITY ASSURANCE**

- Electrical Components, Devices, and Accessories: Listed and labeled as defined in Α. NFPA 70, Article 100, by a testing agency acceptable to authorities having jurisdiction, and marked for intended use.
- B. The Contractor shall utilize a manufacturer's authorized distributor/integrator of the equipment supplied for this project location with full manufacturer's warranty privileges The CCTV distributor/integrator shall be an established communications and electronics agency with at least five years' experience in similar projects.
- C. The Contractor shall submit satisfactory evidence, upon request, that the CCTV distributor/integrator maintains a fully equipped service organization capable of furnishing adequate inspection and service to the system. The distributor/integrator shall maintain at his facility the necessary spare parts in the proper proportion as recommended by the manufacturer to maintain and service the equipment being supplied.
- D. The CCTV distributor/integrator providing equipment shall be responsible for providing all specified equipment and mentioned services for all equipment specified herein. The agency must be a local authorized distributor of all specified equipment for single source of responsibility and shall provide documents proving such. The agency must provide written proof that the agency is adequately staffed with factory-trained technicians for all of the specified equipment. The agency must have established business for and currently be providing all services for the equipment to be provided for a minimum of five (5) years.

#### PART 2 - PRODUCTS

#### 2.1 **MANUFACTURERS**

Α. Manufacturers: Acceptable manufacturers are Avigilon, Bosch, Vivotek or approved equal.

## 2.2 SYSTEM REQUIREMENTS

- A. General: Furnish and install all equipment, accessories, and materials in accordance with these specifications and drawings to provide a complete and operating Closed Circuit Television System. The system shall have cameras as located in contract documents. The System shall meet the following:
  - 1. 30 Days recording capacity of all cameras, real time at 30 FPS with average activity 14 hours a day. Low activity on motion the other 10 hours.

## 2.3 CONTROL HARDWARE AND SOFTWARE

#### A. Overview

 Software that enables personnel to easily and remotely gather video evidence, monitor live situations, and configure and maintain a video surveillance system over Ethernet consisting of network video recorders (NVRs) and IP video cameras.

## B. Client Hardware Requirements

1. Provide client workstation per CCTV equipment manufacturers recommendations/requirements.

#### 2.4 CAMERAS

- A. Indoor Dome Cameras: Fixed Dome, 8MP, Infrared, onboard analytics, PTZ; Capture, encode and transmit video over a network.
- B. Outdoor Dome Cameras: Fixed Dome, 8MP, Infrared, onboard analytics, PTZ; Capture, encode and transmit video over a network.
- C. Owner requested Camera: Coordinate system with owner and project team prior to ordering.

#### 2.5 NETWORK VIDEO RECORDERS

- A. The Network Video Recorder (NVR) with Ethernet connectivity shall require minimal training for the end user. The unit shall be operated like a conventional multiplexer and VCR with local display monitors for live and playback viewing while the system continues to record new images. It shall be an integrated security system, capable of time division multiplexing and real time recording multiple cameras, and storing their digitized and compressed images on integral hard disk drives for fast search and retrieval either locally at the unit, or from a remote workstation using a Graphical User Interface (GUI).
- B. The NVR shall have the following operational features:
  - 1. Recording
    - a. Shall record video on a hard disk drive.
    - b. Shall support both internal and external hard disk configurations.
    - c. Shall support an alarm record mode that is user programmable.

- d. The user shall be able to play back images smoothly at normal or fast speeds and in forward modes, without distortion.
- e. The NVR shall provide full media search capabilities for archiving, restoring, and playback operations. Search capabilities shall include filters for start/stop times, start/stop dates, alarm and event occurrences, inserted text, and camera number.

#### 2. Archiving

- a. The NVR shall support archiving of recorded images through USB memory stick.
- Video motion detection
  - The NVR shall support the following video motion detection, with onscreen indications when motion is occurring:
  - b. Motion detection, which shall be treated as an alarm.

#### PART 3 - EXECUTION

#### 3.1 WIRING

- A. Wiring Method: Install all CCTV cables in continuous raceways. CCTV system and raceways to be removed after completion of construction. CCTV installation shall not damage or alter final interior finishes. Provide all cabling as per manufacturer.
- B. Grounding: Provide independent-signal circuit grounding recommended in writing by manufacturer.

# 3.2 VIDEO SURVEILLANCE SYSTEM INSTALLATION


- A. Install cameras in accordance with manufacturer's recommendations and installation guidelines.
- B. Install power supplies and other auxiliary components as required by manufacturer.

# 3.3 FIELD QUALITY CONTROL

- A. Manufacturer's Field Service: Engage a factory-authorized service representative to inspect field-assembled components and equipment installation and supervise pretesting, testing, and adjusting of video surveillance equipment.
- B. Inspection: Verify that units and controls are properly installed, connected, and labeled, and that interconnecting wires and terminals are identified.
- C. Pre-testing: Align and adjust system and pretest components, wiring, and functions to verify that they comply with specified requirements. Conduct tests at varying lighting levels, including day and night scenes as applicable. Prepare video surveillance equipment for acceptance and operational testing as per manufacturer's recommendations.
- D. Test Schedule: Schedule tests after pre-testing has been successfully completed and system has been in normal functional operation for at least 14 days. Provide a minimum of 10 days' notice of test schedule.

- E. Operational Tests: Perform operational system tests to verify that system complies with Specifications. Include all modes of system operation. Test equipment for proper operation in all functional modes.
- F. Remove and replace malfunctioning items and retest as specified above.
- G. Record test results for each piece of equipment.
- H. Retest: Correct deficiencies identified by tests and observations and retest until specified requirements are met.

END OF SECTION 28 2310

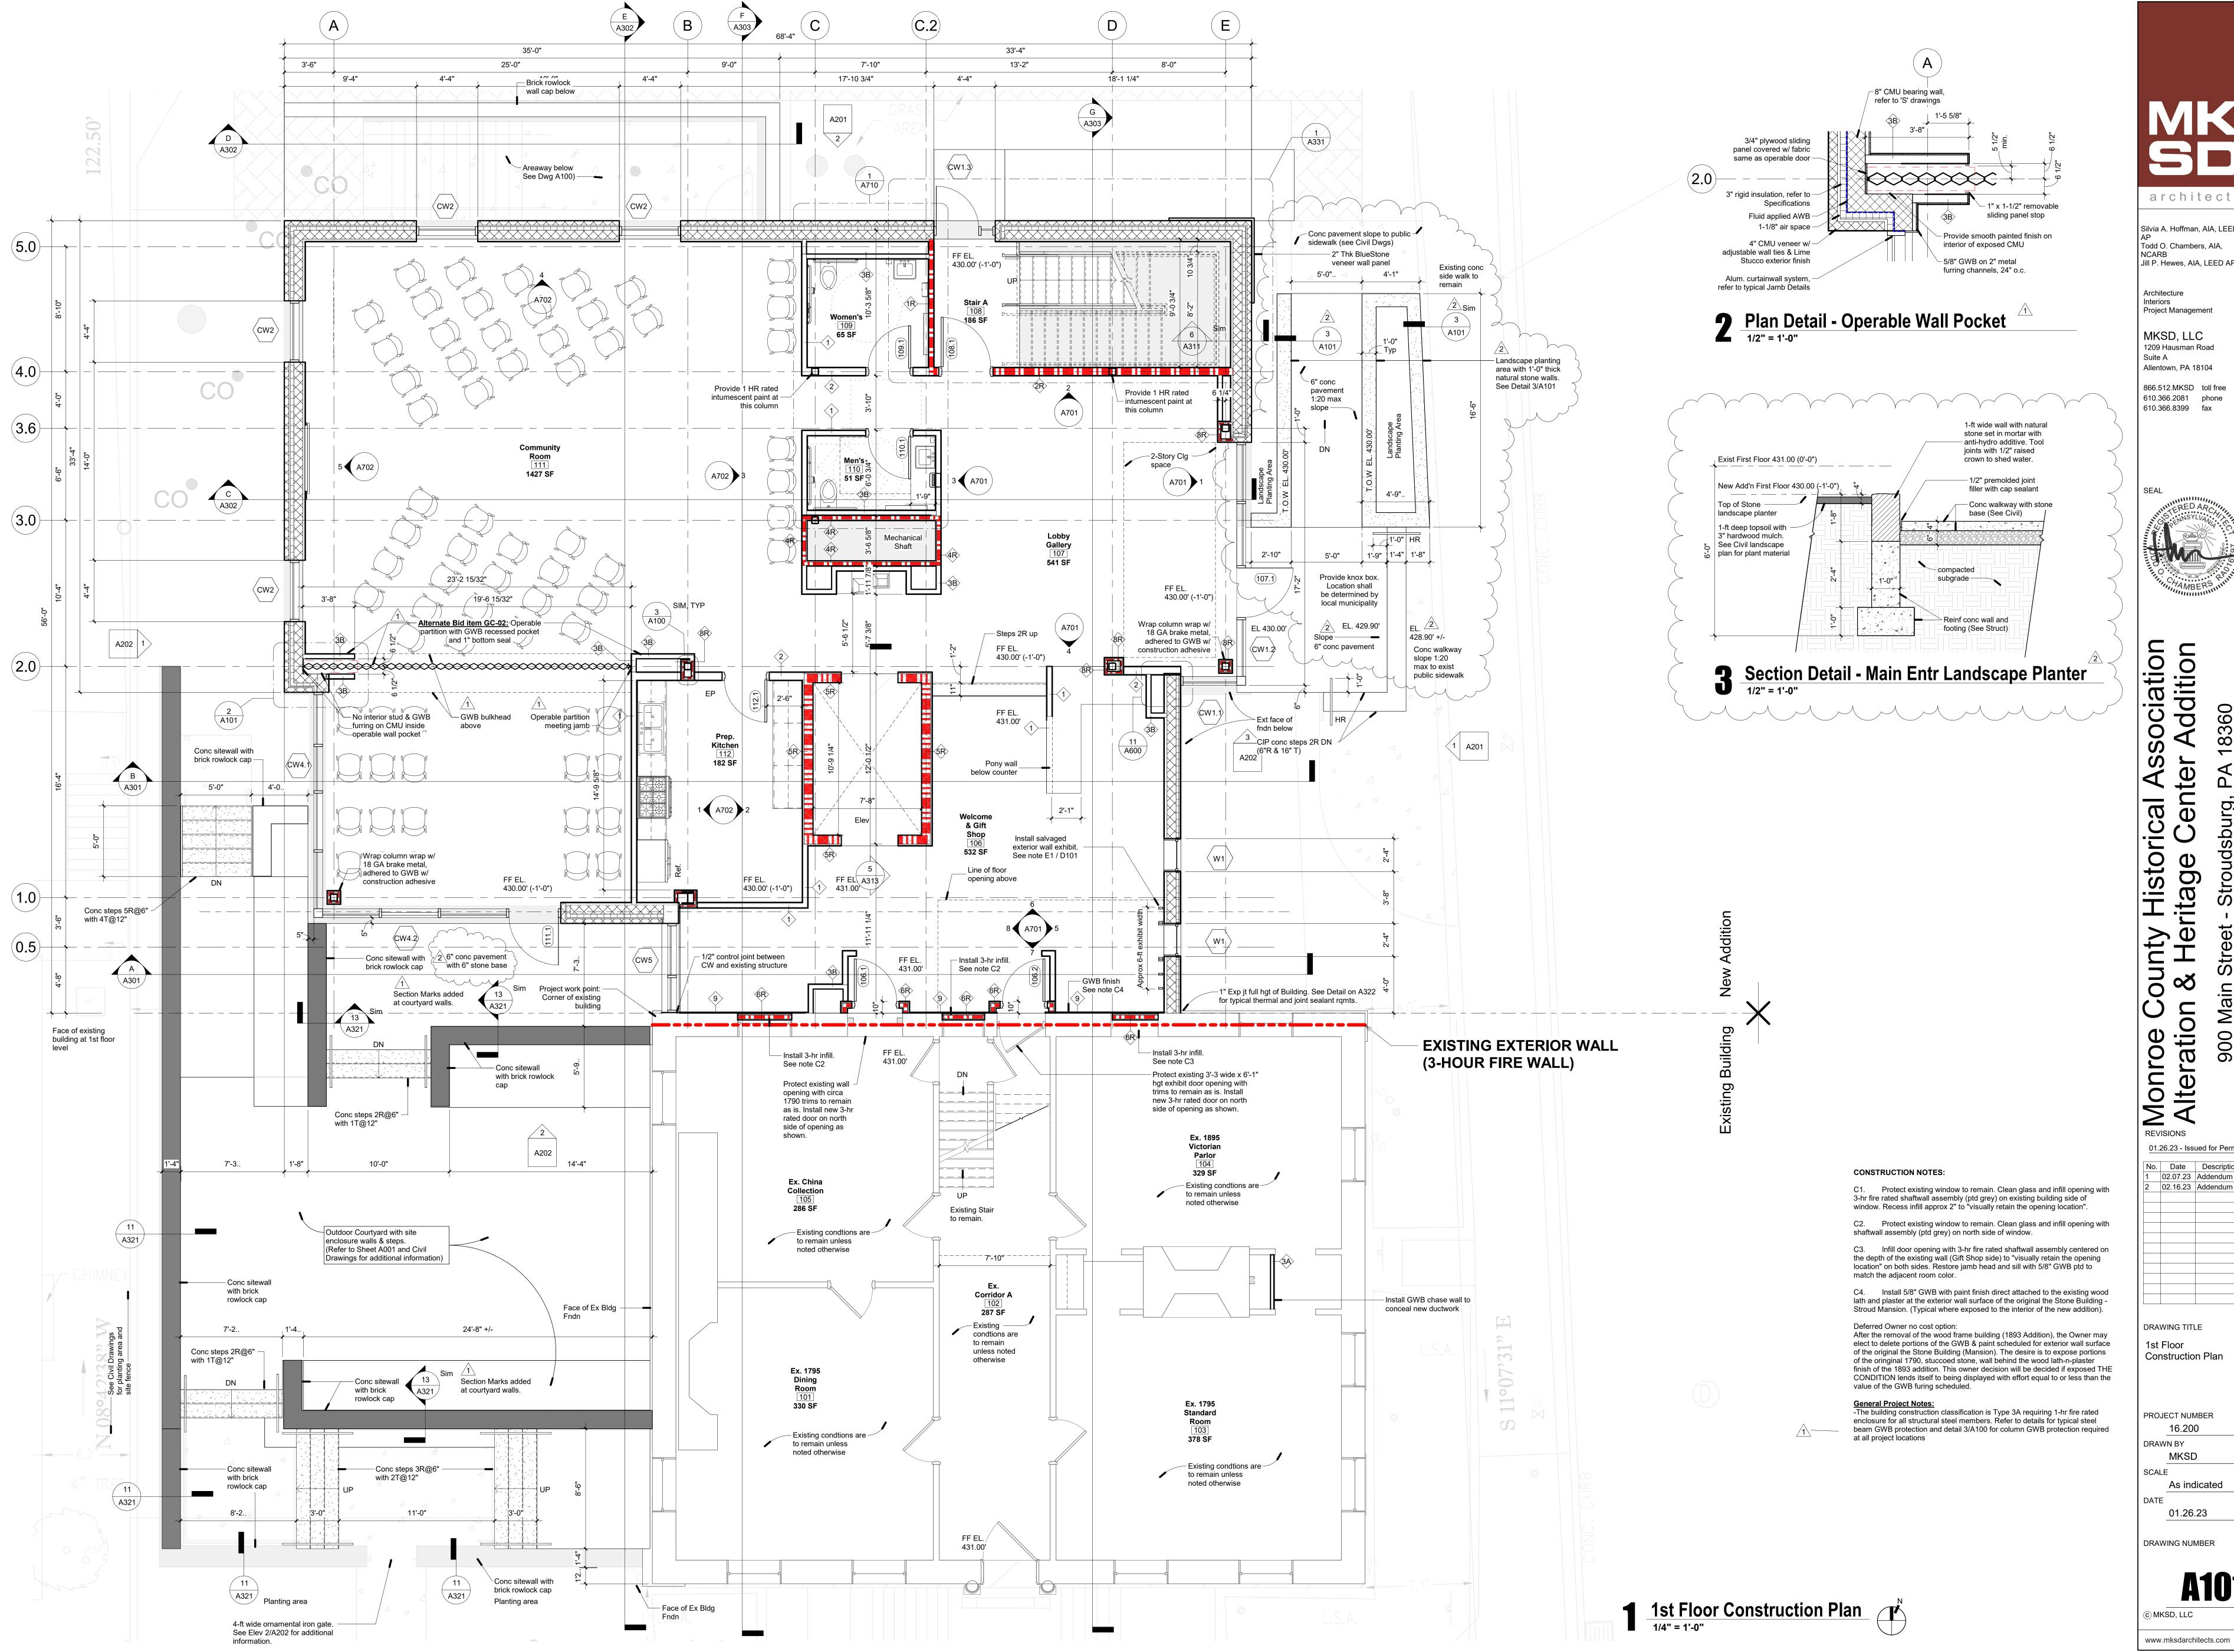



architects Silvia A. Hoffman, AIA, LEED

Todd O. Chambers, AIA, Jill P. Hewes, AIA, LEED AP

Architecture Interiors **Project Management** MKSD, LLC 1209 Hausman Road

Suite A Allentown, PA 18104 866.512.MKSD toll free 610.366.2081 phone

610.366.8399 fax

sociation Addition 900 REVISIONS

01.26.23 - Issued for Permit 02.07.23 Addendum 1 02.16.23 Addendum 2


DRAWING TITLE 1st Floor Construction Plan

PROJECT NUMBER 16.200 DRAWN BY

MKSD SCALE As indicated

01.26.23

c MKSD, LLC

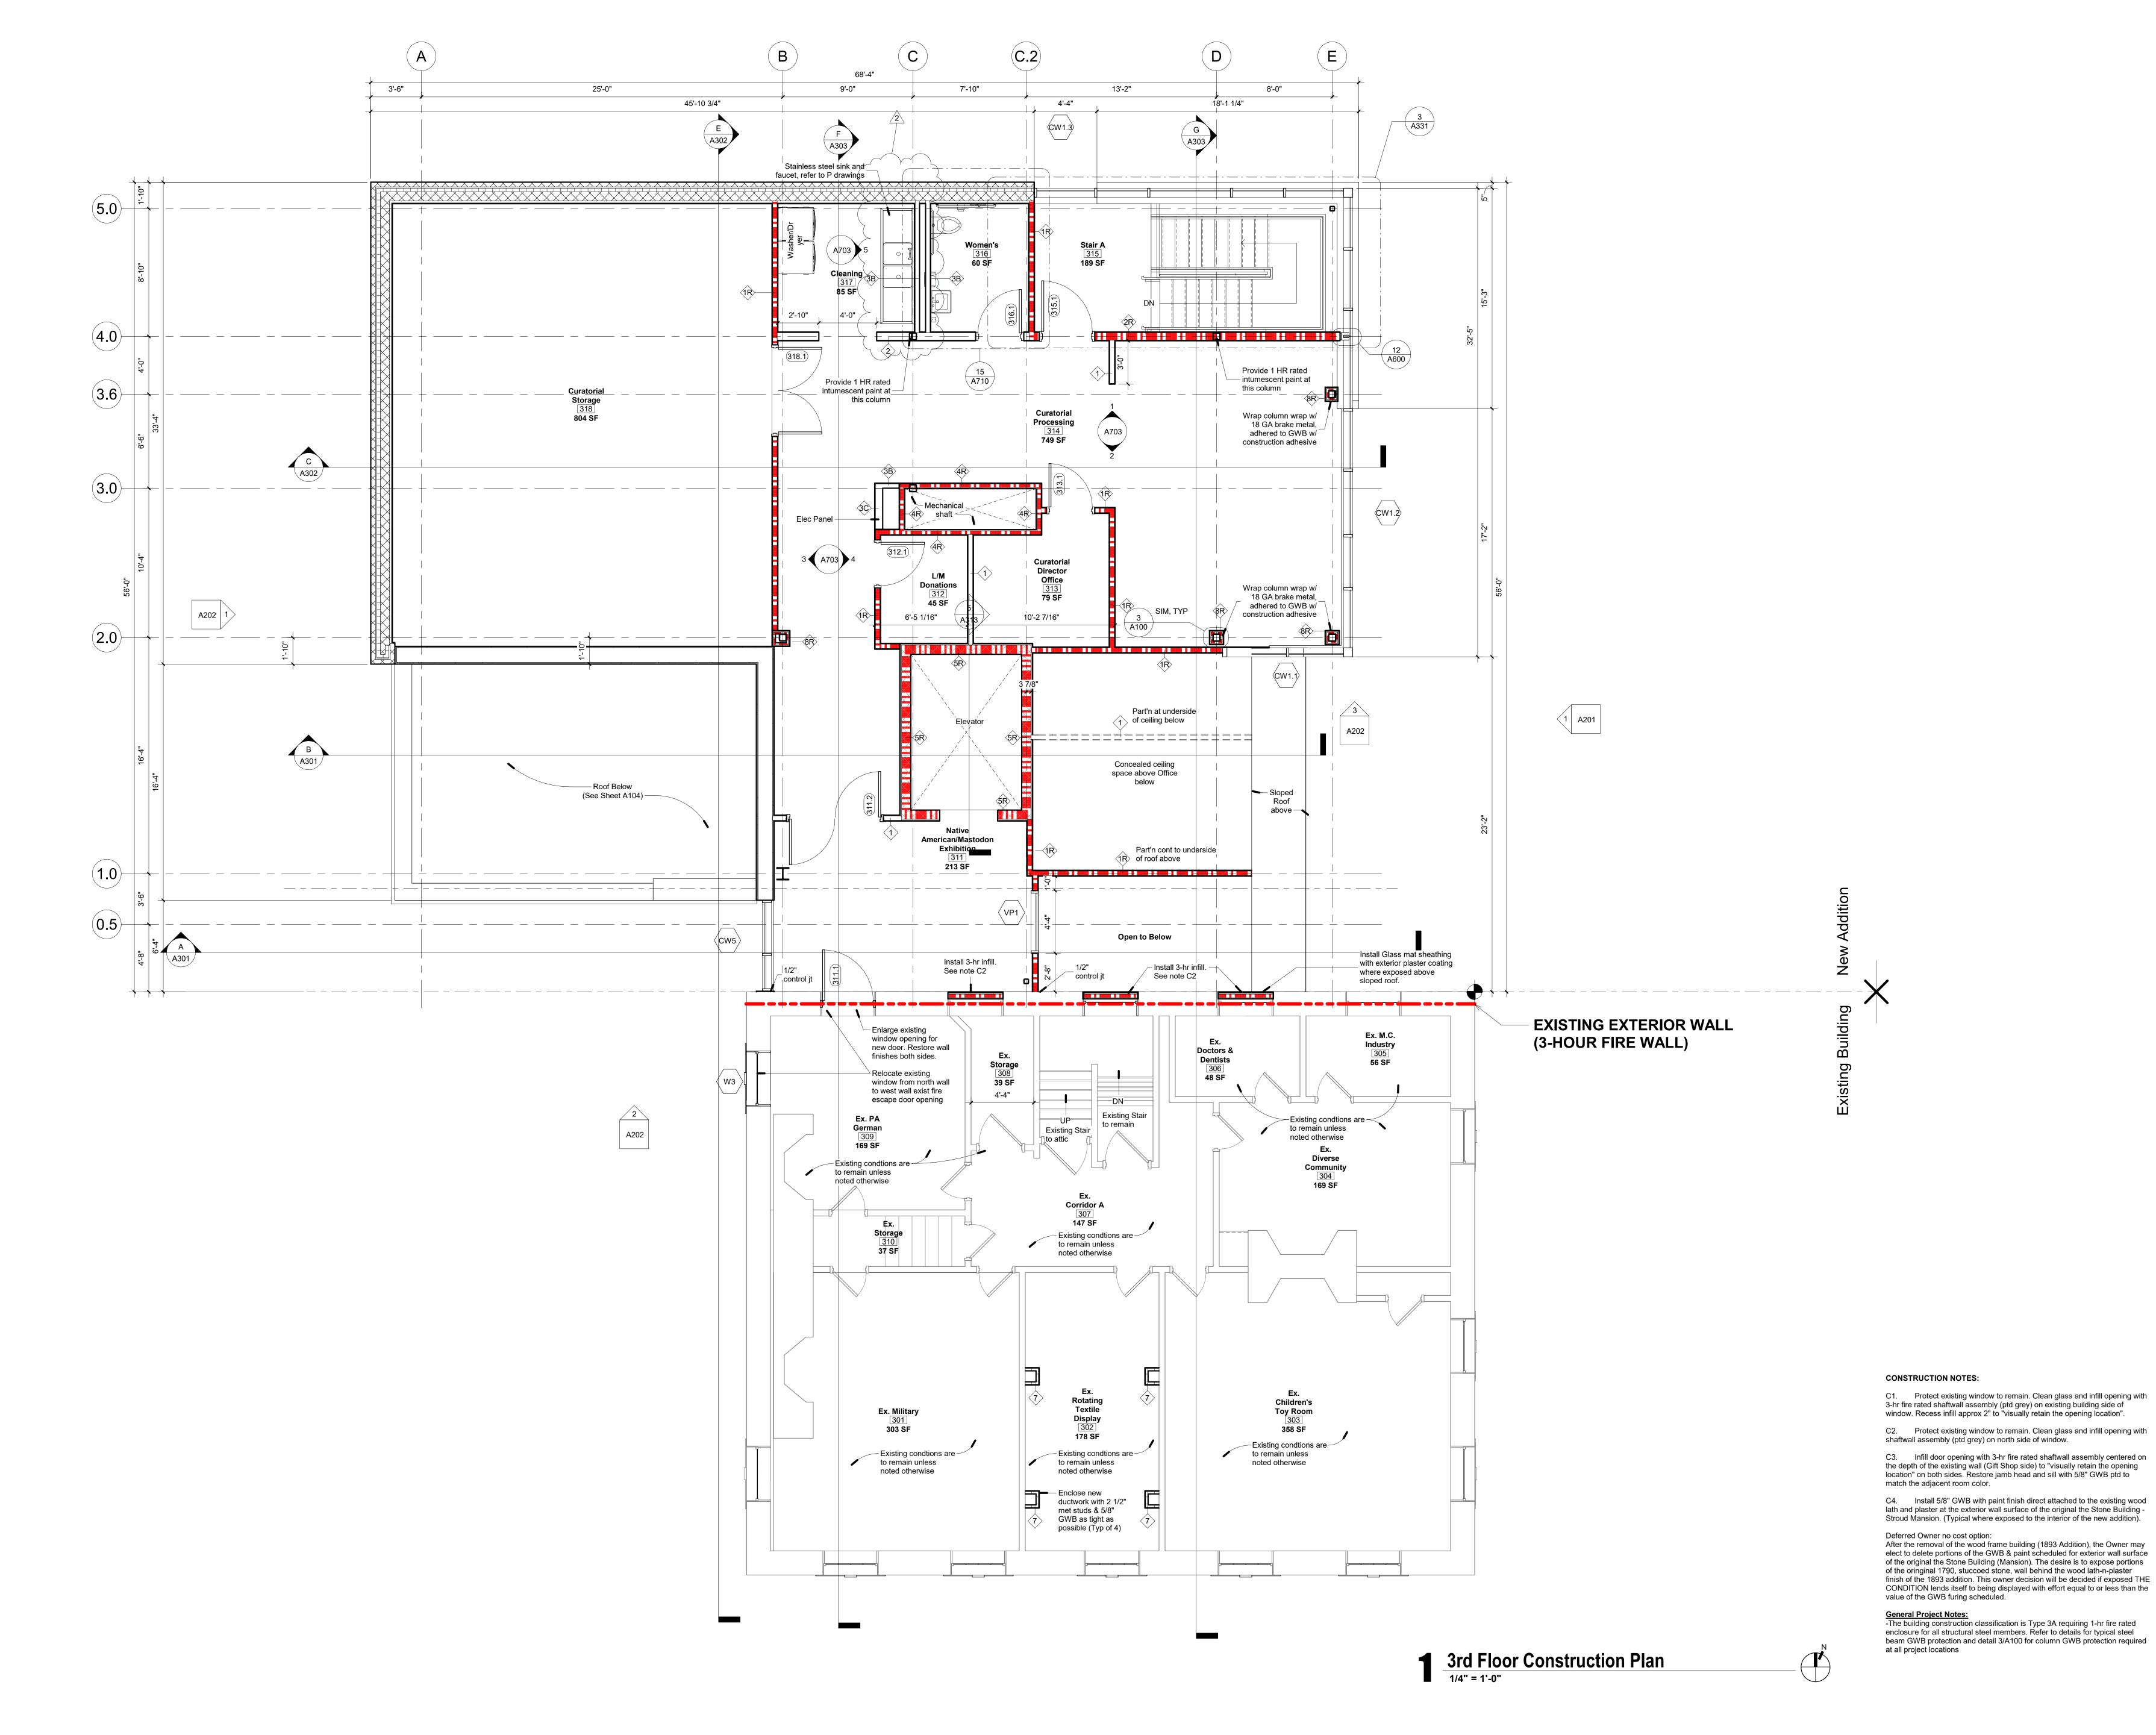




Silvia A. Hoffman, AIA, LEED Todd O. Chambers, AIA, Jill P. Hewes, AIA, LEED AP

> Architecture **Project Management**

MKSD, LLC 1209 Hausman Road Suite A

Allentown, PA 18104 866.512.MKSD toll free 610.366.2081 phone 610.366.8399 fax



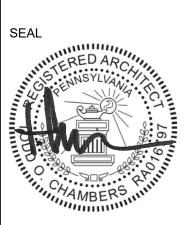

Association ter Addition 900 Main **REVISIONS** 

01.26.23 - Issued for Permit

02.07.23 Addendum 1 02.16.23 Addendum 2

DRAWING TITLE 3rd Floor Construction Plan

PROJECT NUMBER 16.200


DRAWN BY MKSD SCALE

DATE 01.26.23

1/4" = 1'-0"

DRAWING NUMBER

c MKSD, LLC www.mksdarchitects.com

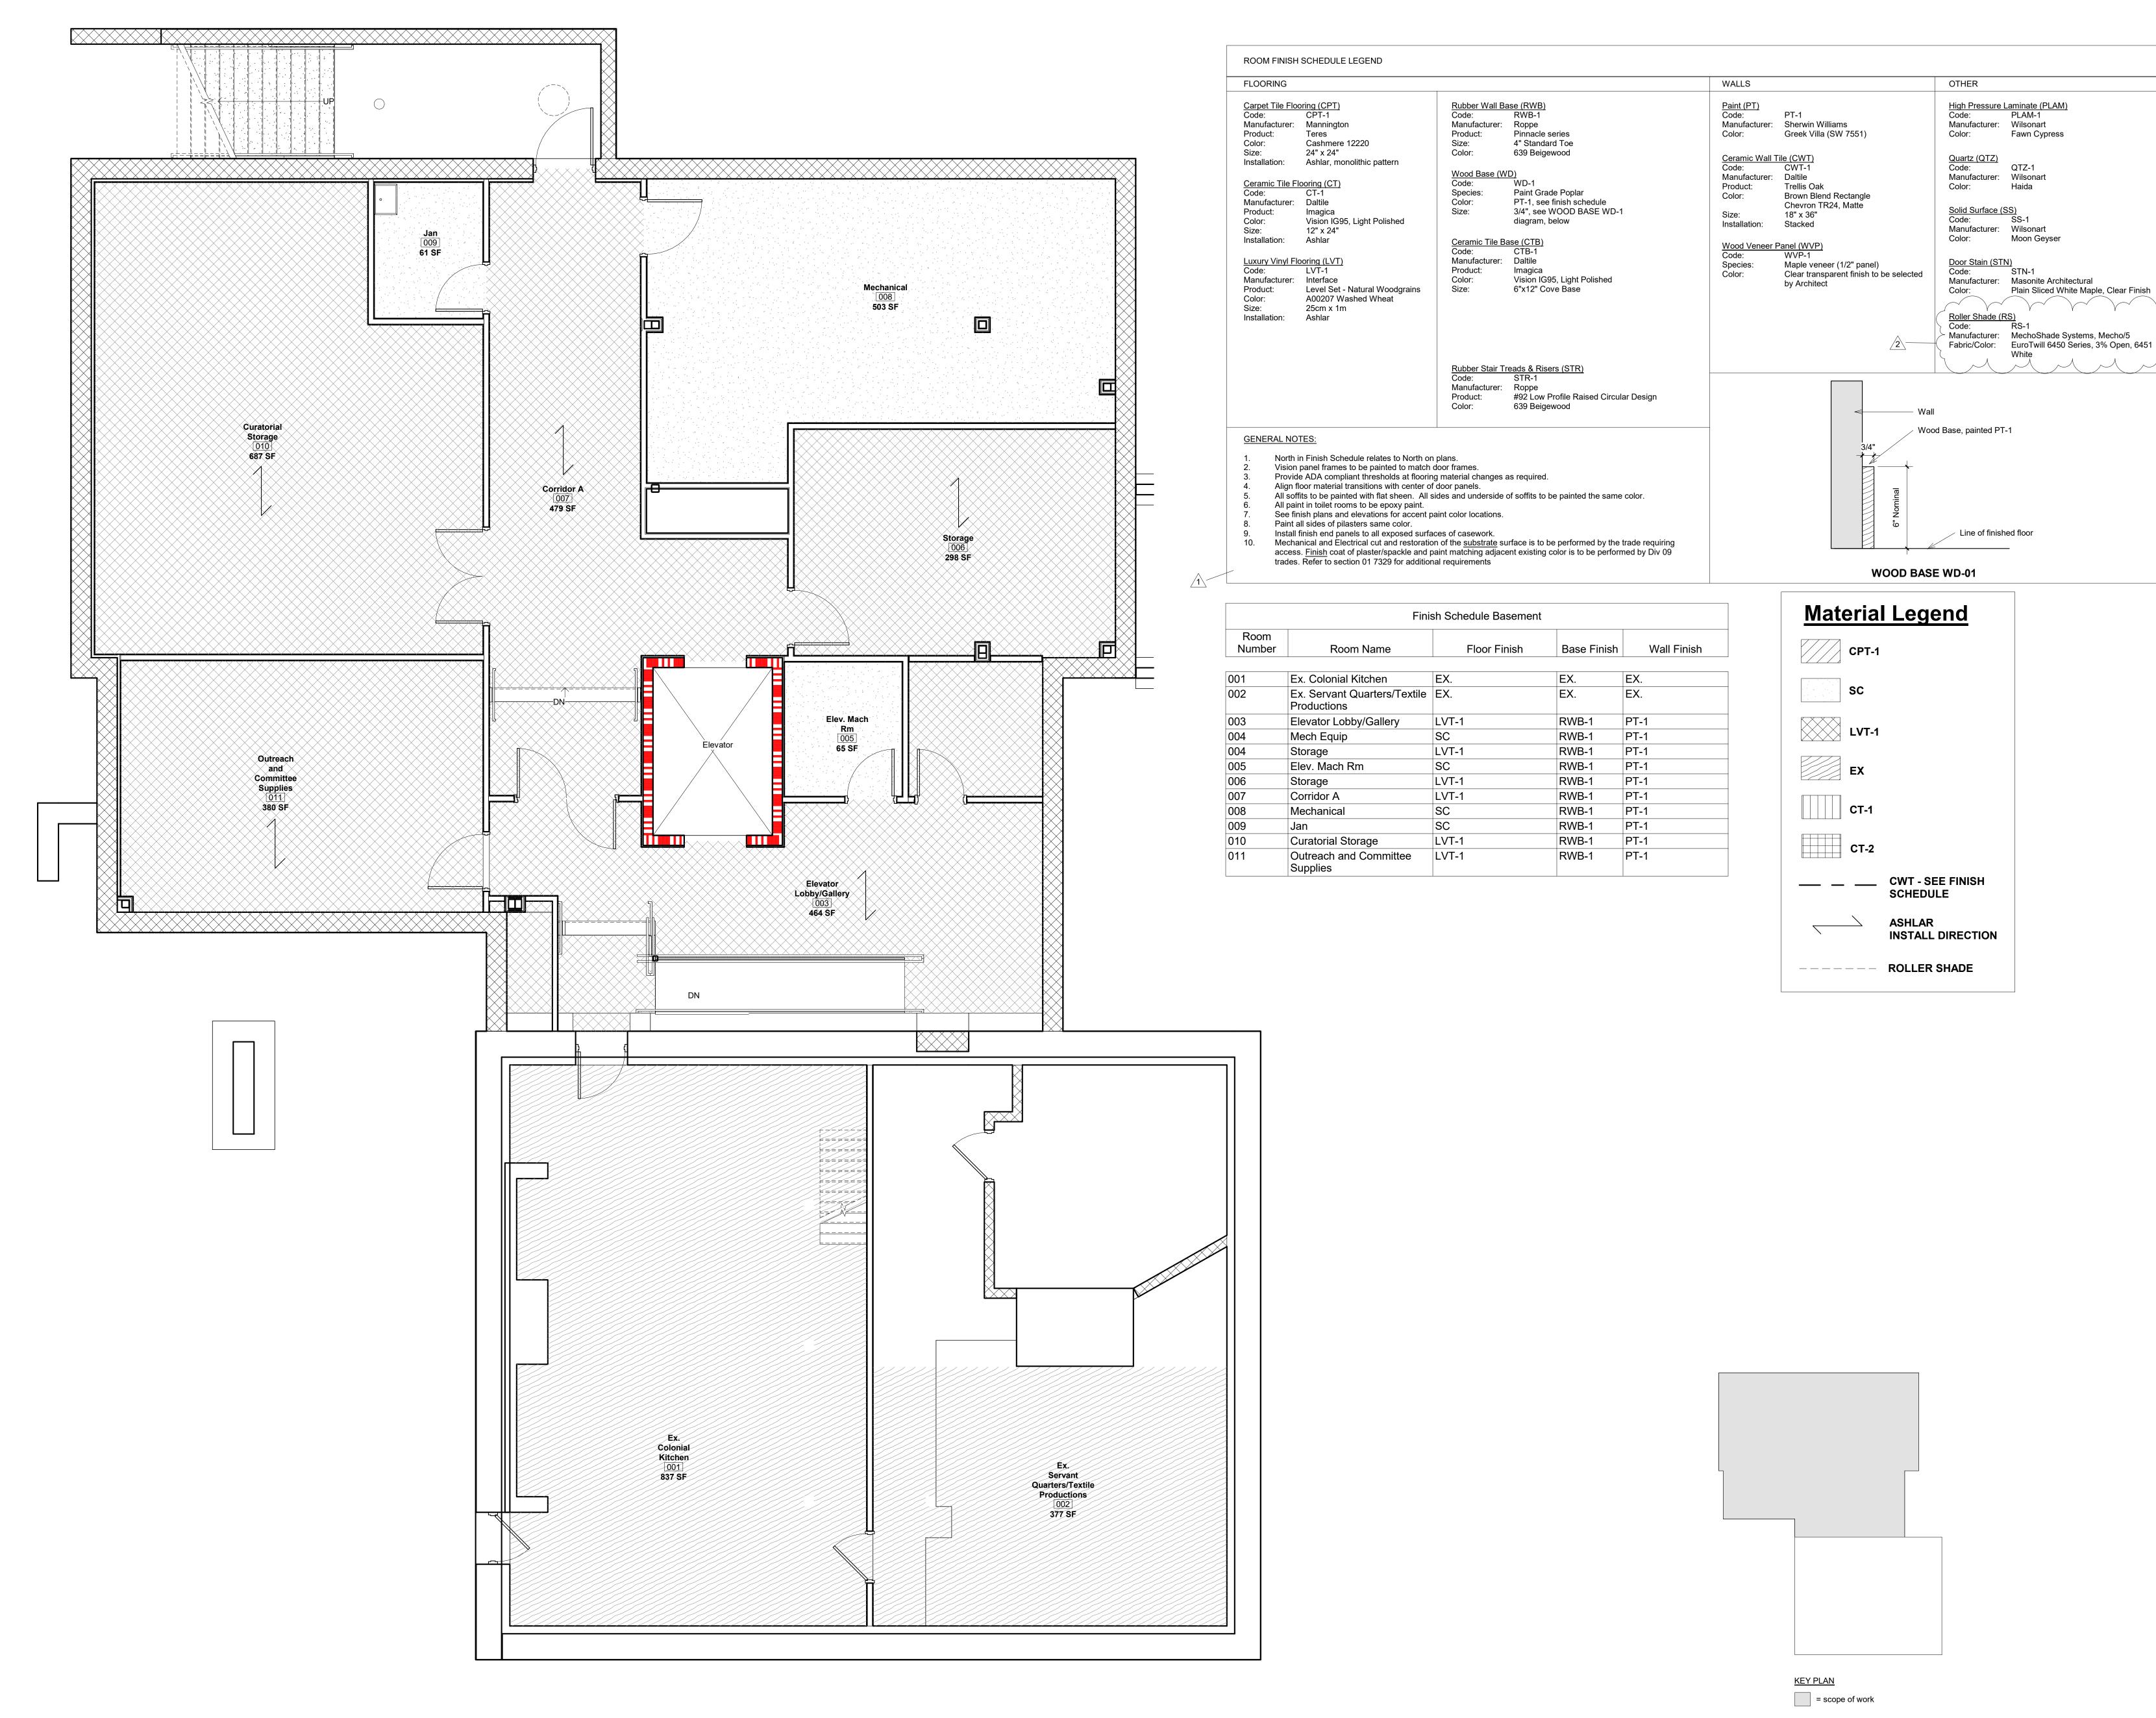

architects

Silvia A. Hoffman, AIA, LEED Todd O. Chambers, AIA,

NCARB Jill P. Hewes, AIA, LEED AP Architecture

Interiors Project Management MKSD, LLC 1209 Hausman Road Suite A

Allentown, PA 18104 866.512.MKSD toll free 610.366.2081 phone 610.366.8399 fax



Association Iter Addition County Historical Ason & Heritage Center

900 Main Monroe Co SNOISINAL Alteration

01.26.23 - Issued for Permit 02.07.23 Addendum 1 02.16.23 Addendum 2

DRAWING TITLE Basement Finish

Plan and Details


PROJECT NUMBER 16.200


DRAWN BY

As indicated 01.26.23


DRAWING NUMBER A500


MKSD, LLC www.mksdarchitects.com

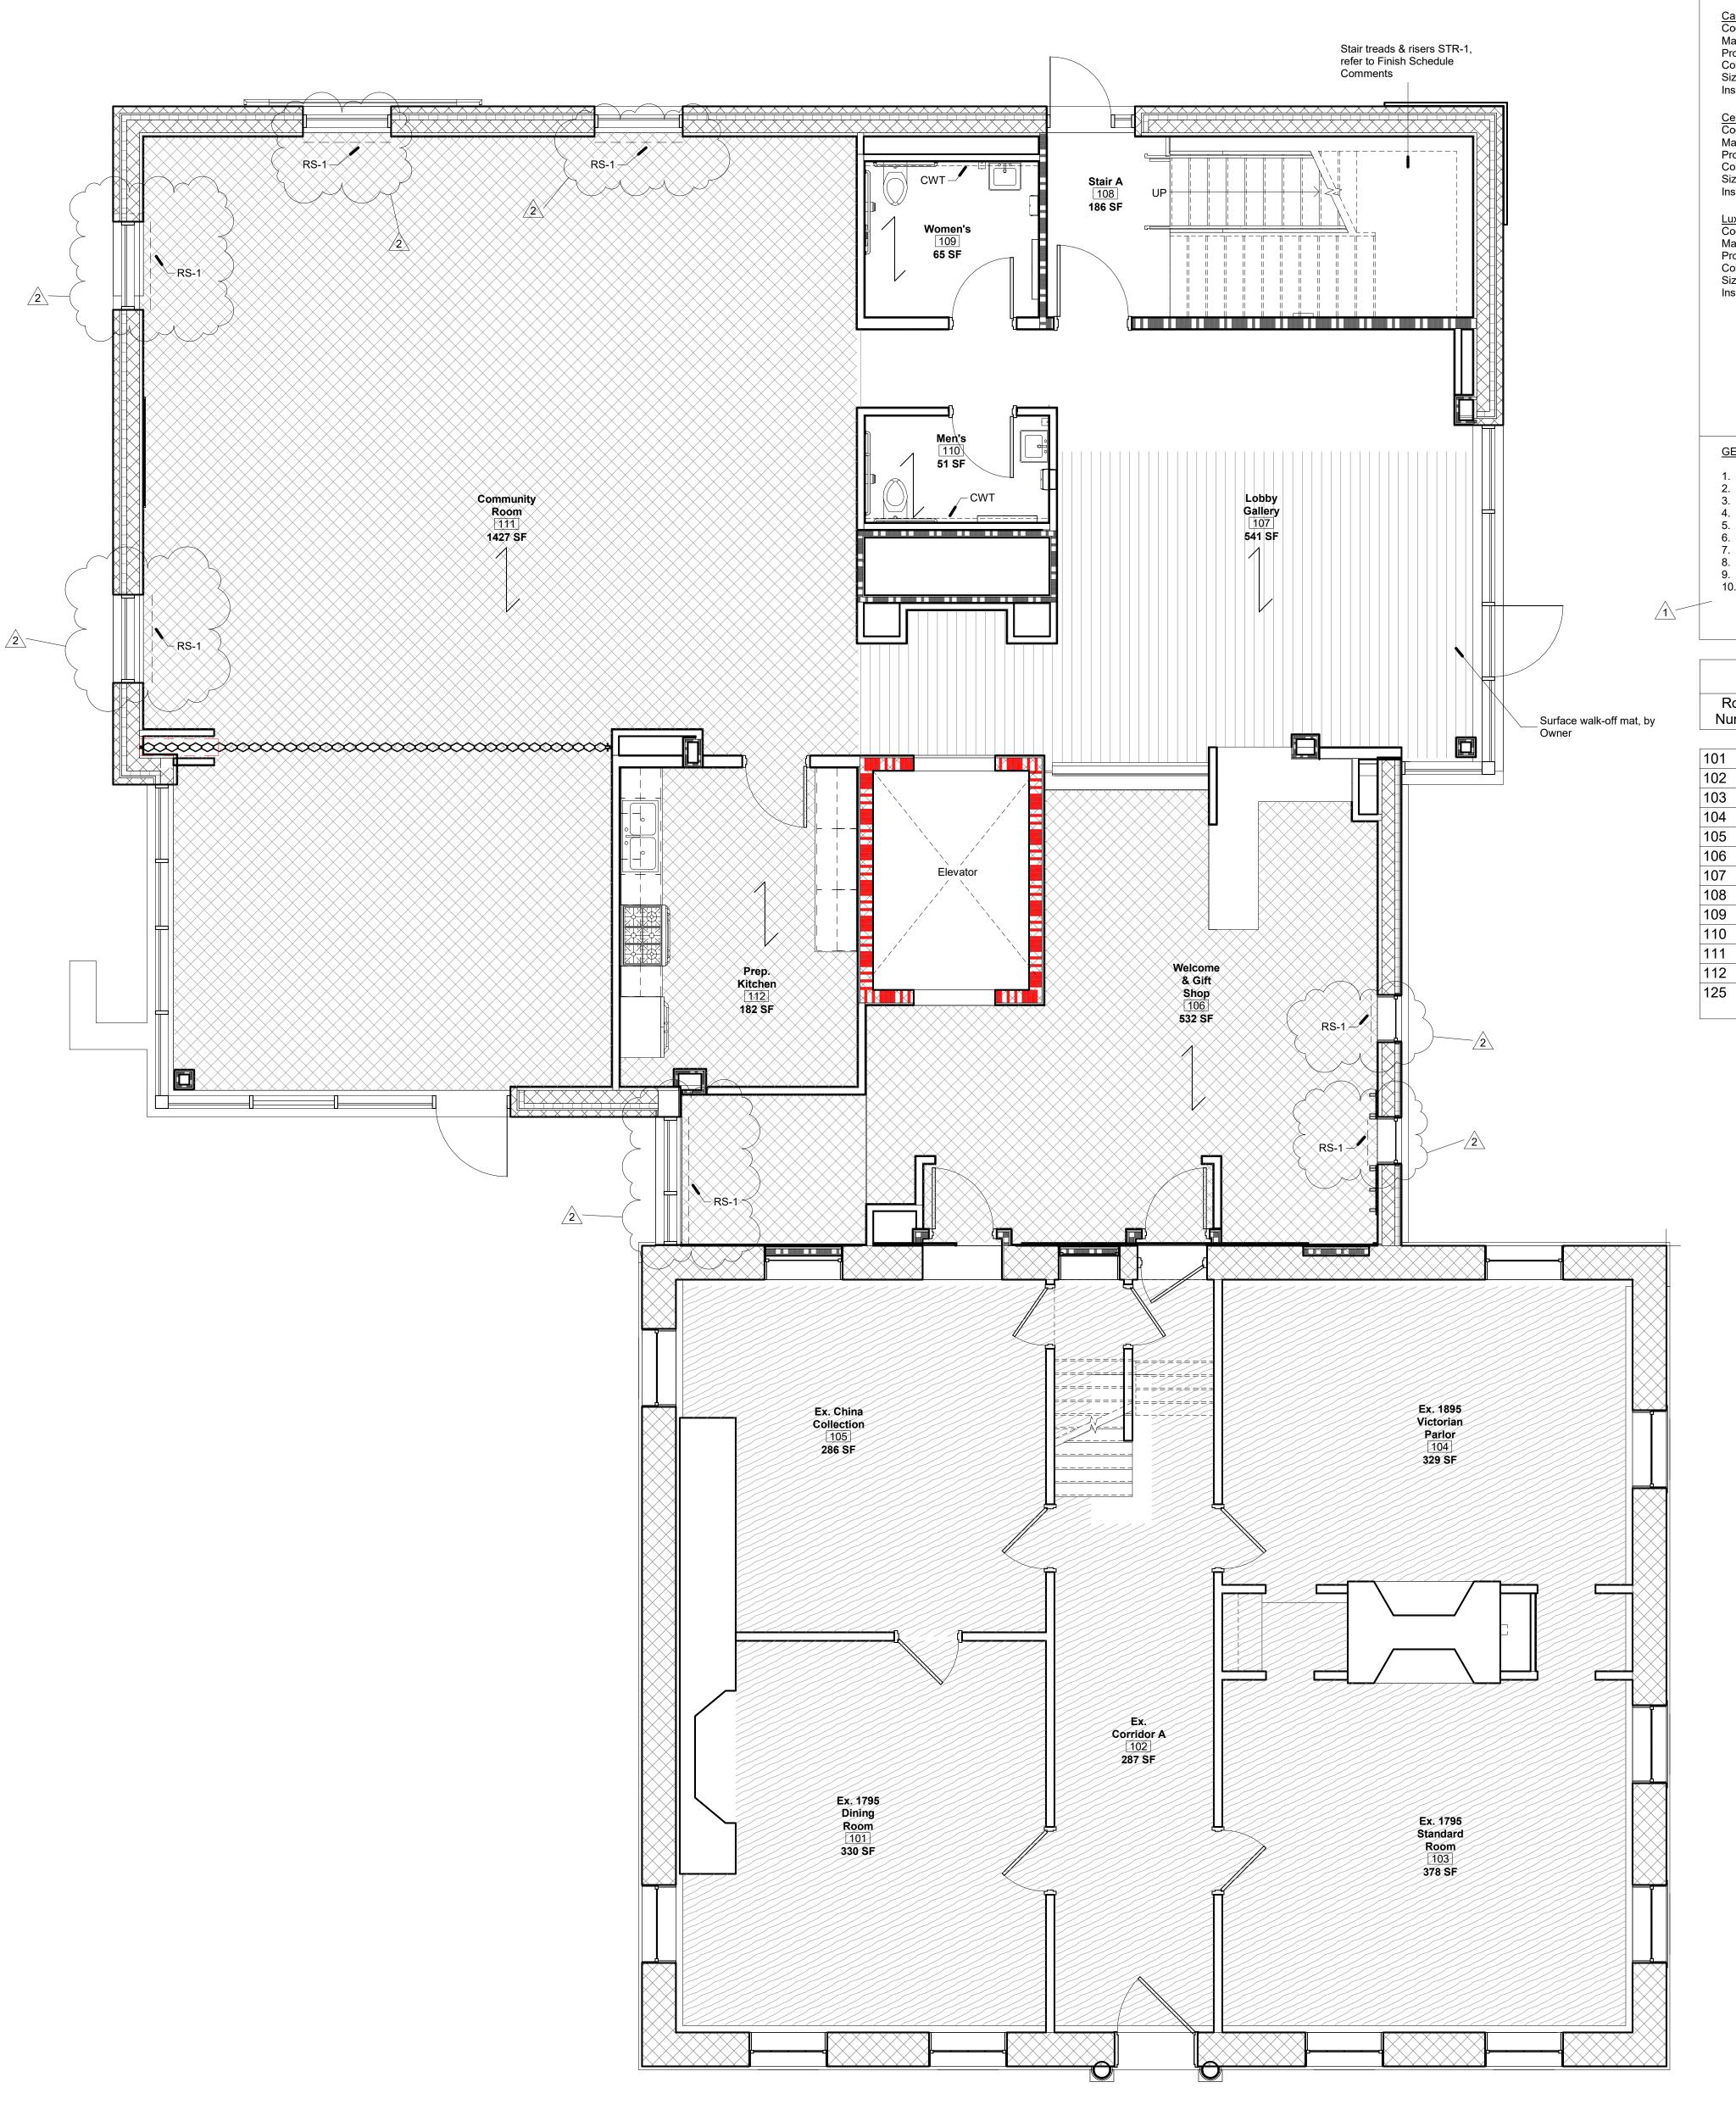


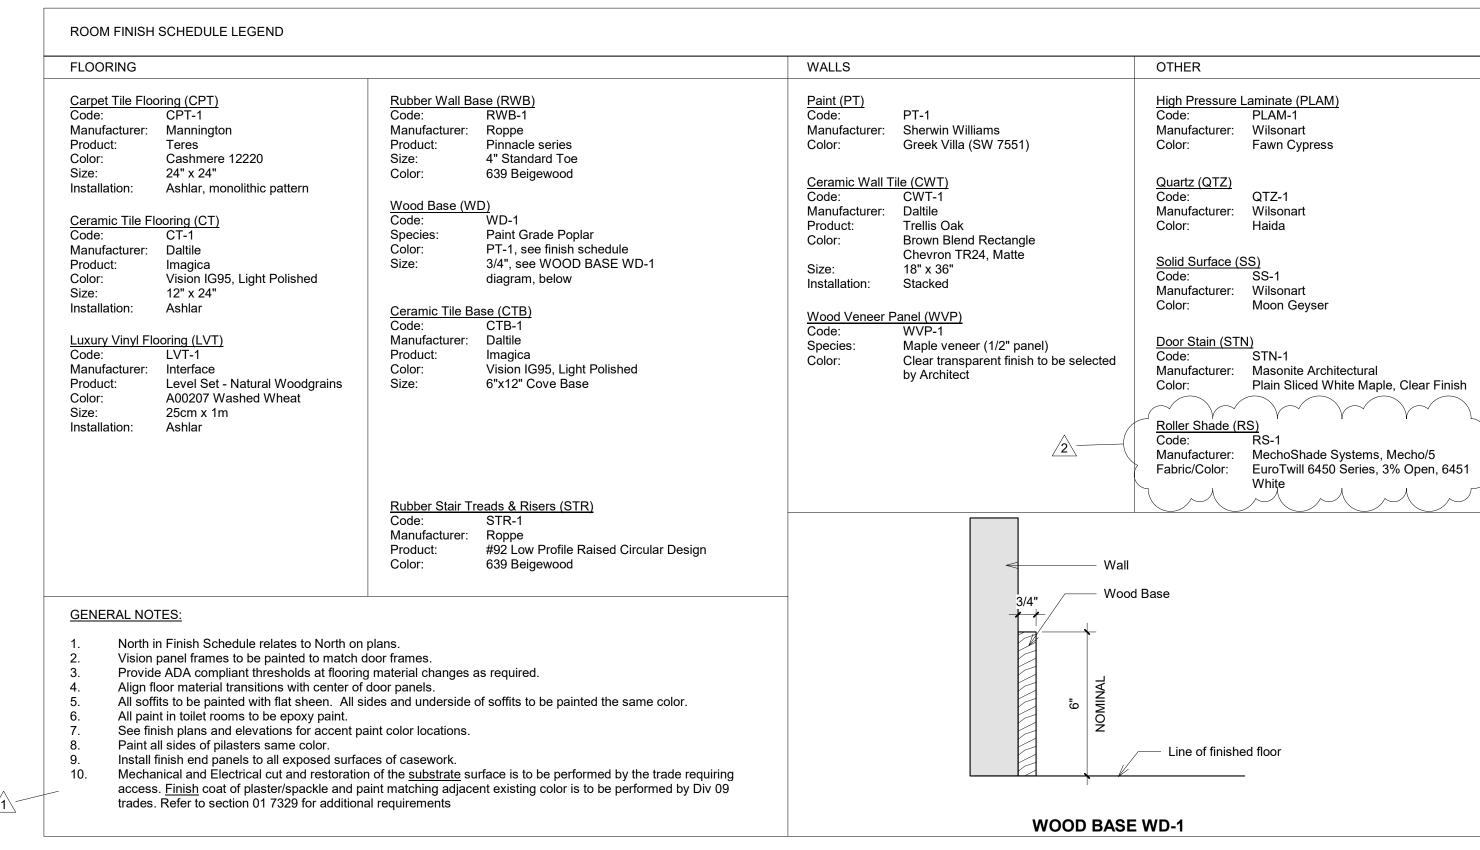



		F	Finish Schedule 1	st Floor	
Room Number	Room Name	Floor Finish	Base Finish	Wall Finish	Other
101	Ex. 1795 Dining Room	EX.	EX.	EX.	
102	Ex. Corridor A	EX.	EX.	EX.	
103	Ex. 1795 Standard Room	EX.	EX.	EX.	
104	Ex. 1895 Victorian Parlor	EX.	EX.	EX.	
105	Ex. China Collection	EX.	EX.	EX.	
106	Welcome & Gift Shop	LVT-1	WD-1	PT-1	
107	Lobby Gallery	CT-1	WD-1	PT-1	
108	Stair A	CT-1	RWB-1	PT-1	Stair tread, risers, and intermediate landings ST-1
109	Women's	CT-1	CTB-1	PT-1, CWT-1	
110	Men's	CT-1	CTB-1	PT-1, CWT-1	
111	Community Room	LVT-1	WD-1	PT-1	
112	Prep. Kitchen	LVT-1	RWB-1	PT-1	
125	Ex. Recreation & Resorts Exhibition	EX.	EX.	EX.	

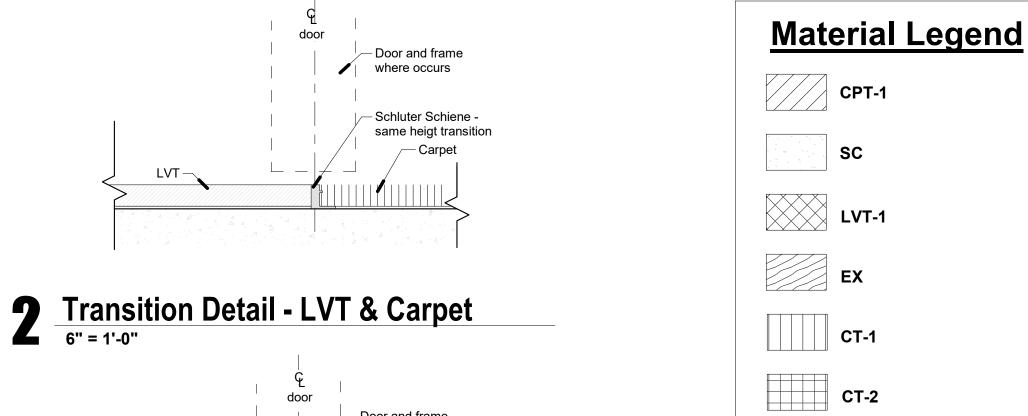


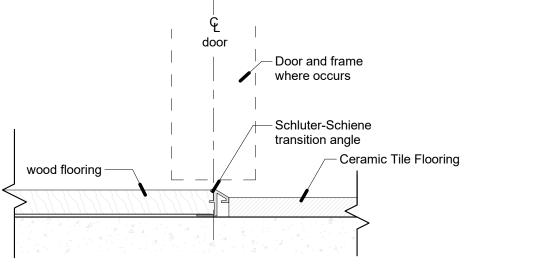

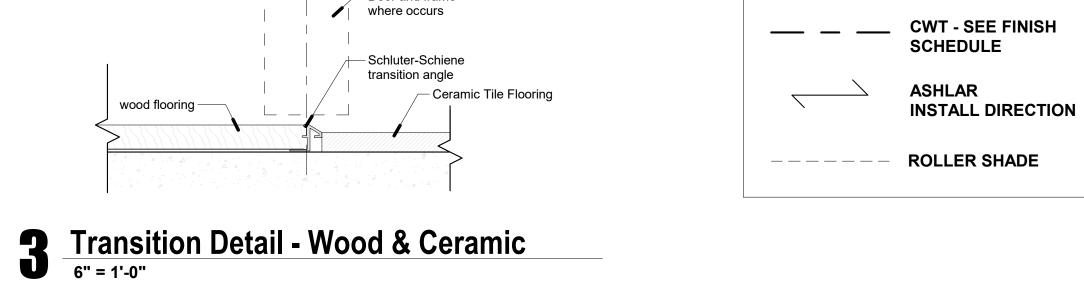

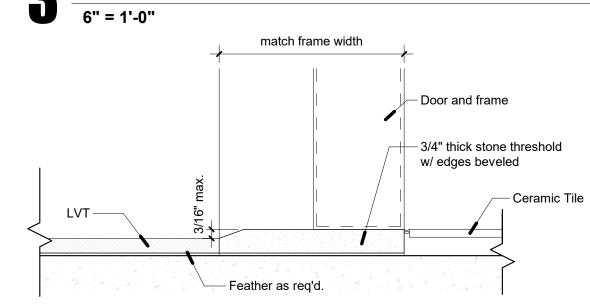

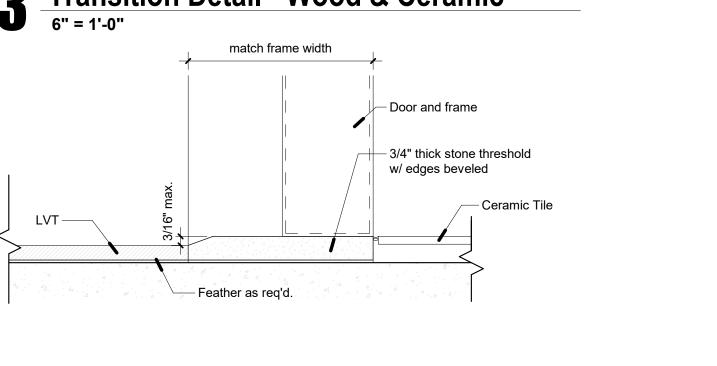

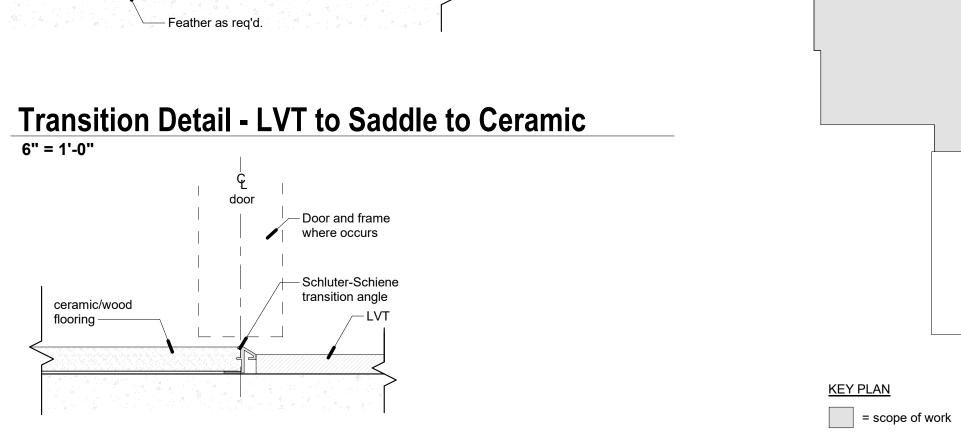

Transition Detail - LVT & Ceramic/Wood

Association Iter Addition Sounty Historical / η & Heritage Cent 900 Main Monroe Co SNOISINAL Alteration

architects

Silvia A. Hoffman, AIA, LEED

Jill P. Hewes, AIA, LEED AP

Todd O. Chambers, AIA,

Architecture Interiors

**Project Management** 

1209 Hausman Road

Allentown, PA 18104

866.512.MKSD toll free

610.366.2081 phone

610.366.8399 fax

MKSD, LLC

Suite A

DRAWING TITLE 1st Floor Finish

01.26.23 - Issued for Permit

02.07.23 Addendum 1 02.16.23 Addendum 2

PROJECT NUMBER 16.200 DRAWN BY


SCALE

As indicated 01.26.23

A501 c MKSD, LLC

www.mksdarchitects.com

DRAWING NUMBER

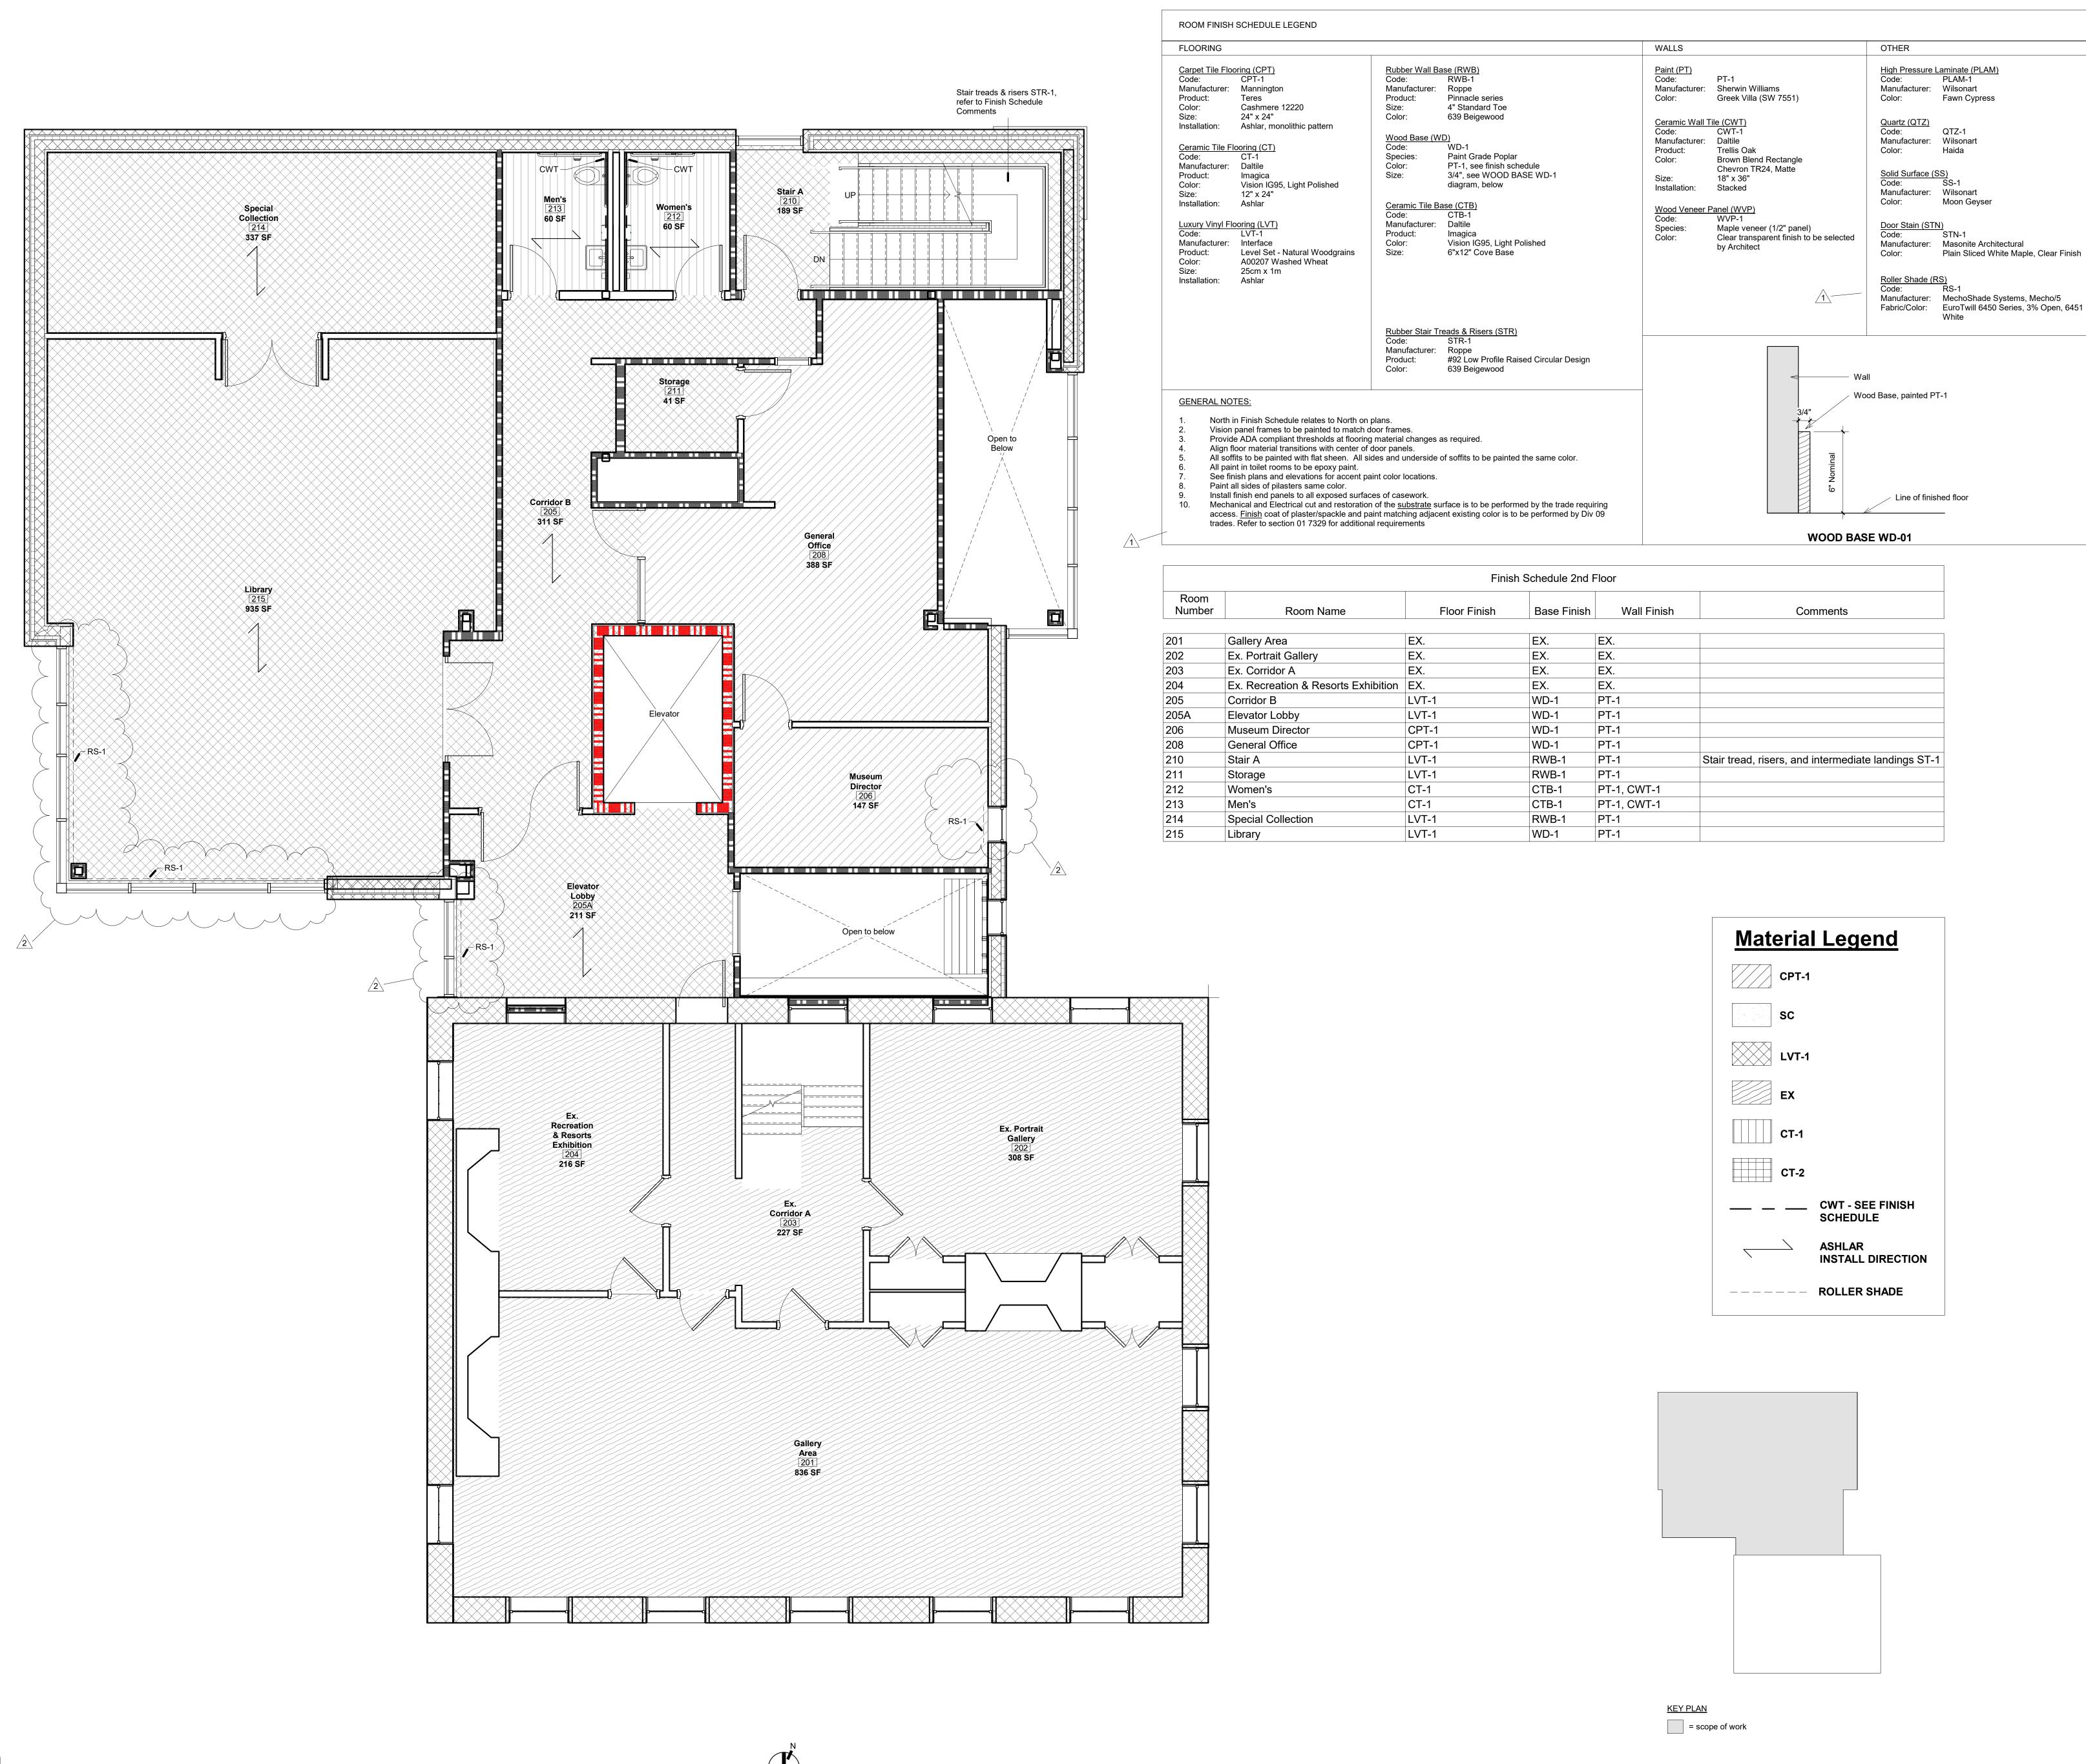


architects


Silvia A. Hoffman, AIA, LEED

Todd O. Chambers, AIA, NCARB Jill P. Hewes, AIA, LEED AP

Architecture Interiors Project Management MKSD, LLC 1209 Hausman Road

Suite A Allentown, PA 18104 866.512.MKSD toll free 610.366.2081 phone 610.366.8399 fax

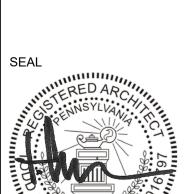

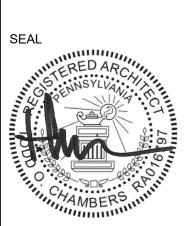

County Historical Association on & Heritage Center Addition 18360 Stroudsburg, PA 900 Main Street -Monroe CC SNOISINE Alteration 01.26.23 - Issued for Permit

02.07.23 Addendum 1 02.16.23 Addendum 2

DRAWING TITLE 2nd Floor Finish

PROJECT NUMBER 16.200

DRAWN BY

SCALE As indicated 01.26.23

DRAWING NUMBER

A502

MKSD, LLC www.mksdarchitects.com



architects


Silvia A. Hoffman, AIA, LEED Todd O. Chambers, AIA, Jill P. Hewes, AIA, LEED AP

Architecture Interiors Project Management

MKSD, LLC 1209 Hausman Road Suite A Allentown, PA 18104

866.512.MKSD toll free 610.366.2081 phone 610.366.8399 fax

SEAL

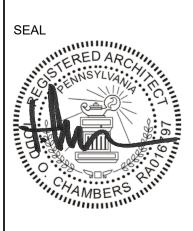

ON County Historical Association & Heritage Center Addition Stroudsburg, PA 900 Main Street -Monroe CC SNOISINE Alteration 01.26.23 - Issued for Permit

02.07.23 Addendum 1 02.16.23 Addendum 2

DRAWING TITLE 3rd Floor Finish


PROJECT NUMBER


16.200 DRAWN BY SCALE As indicated


01.26.23 DRAWING NUMBER

MKSD, LLC

www.mksdarchitects.com

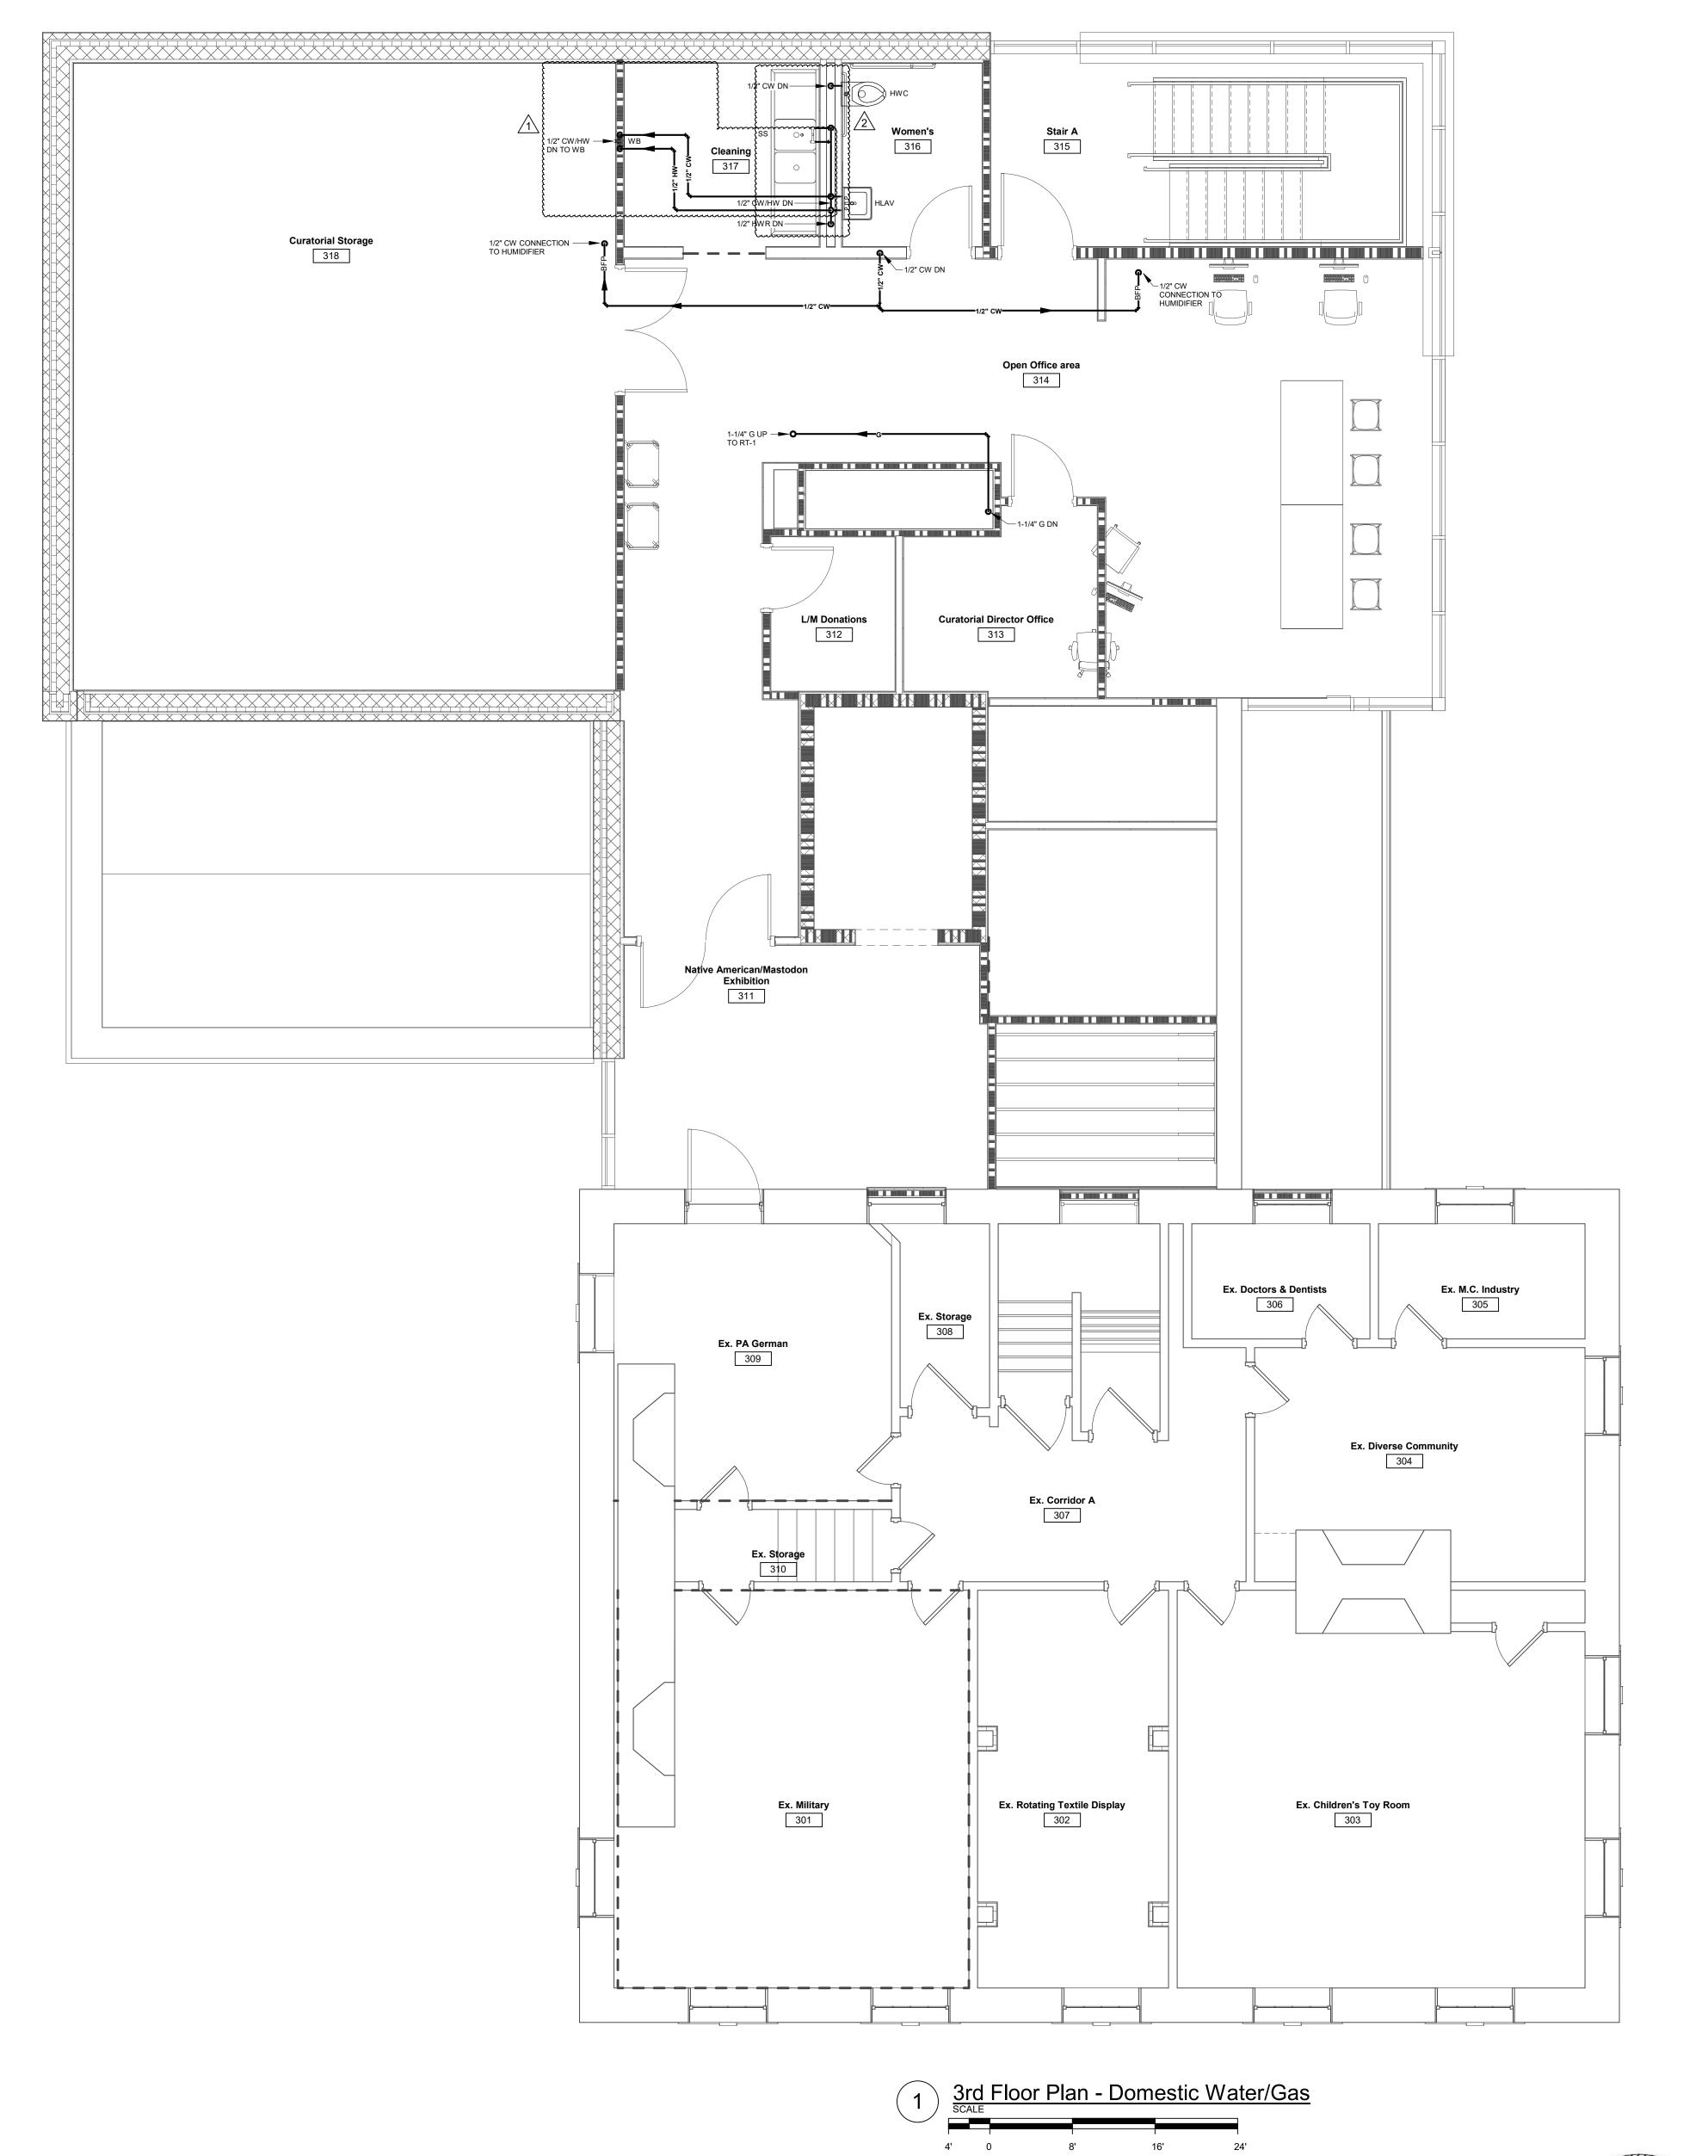

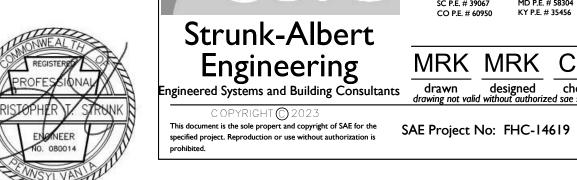

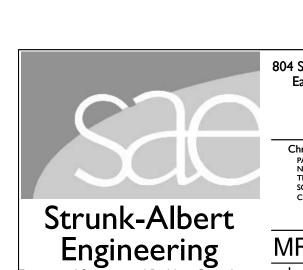

804 Seven Bridge Road, Route 209 East Stroudsburg, PA 18301 T: 570.421.2025 mail@strunk-albert.com www.strunk-albert.com Christopher T. Strunk, P.E. PA P.E. # 080014 NJ P.E. # 24 GE 05567000 NY P.E. # 102070-01 DE P.E. # 24216 TN P.E. # 123268 CT P.E. # 34352 SC P.E. # 39067 MD P.E. # 58304 CO P.E. # 60950 KY P.E. # 35456

MRK MRK CTS Engineered Systems and Building Consultants drawn designed checked drawing not valid without authorized sae signatures

www.mksdarchitects.com

architects

Silvia A. Hoffman, AIA, LEED

Todd O. Chambers, AIA, NCARB Jill P. Hewes, AIA, LEED AP

Architecture Project Management

MKSD, LLC 1209 Hausman Road Suite A Allentown, PA 18104

866.512.MKSD toll free 610.366.2081 phone 610.366.8399 fax

SIGNATURE

Monroe County Historical Association Heritage Center Addition Stroudsburg, 900 Main

01.26.23 - Issued for Permit 
 No.
 Date
 Description

 1
 02.07.23
 Addendum 1

 2
 02.16.23
 Addendum 2

DRAWING TITLE 3rd Floor Plan -Domestic Water/Gas


PROJECT NUMBER 16.200 DRAWN BY

MRK SCALE 1/4" = 1'-0"


DATE 01.26.23

DRAWING NUMBER

© MKSD, LLC

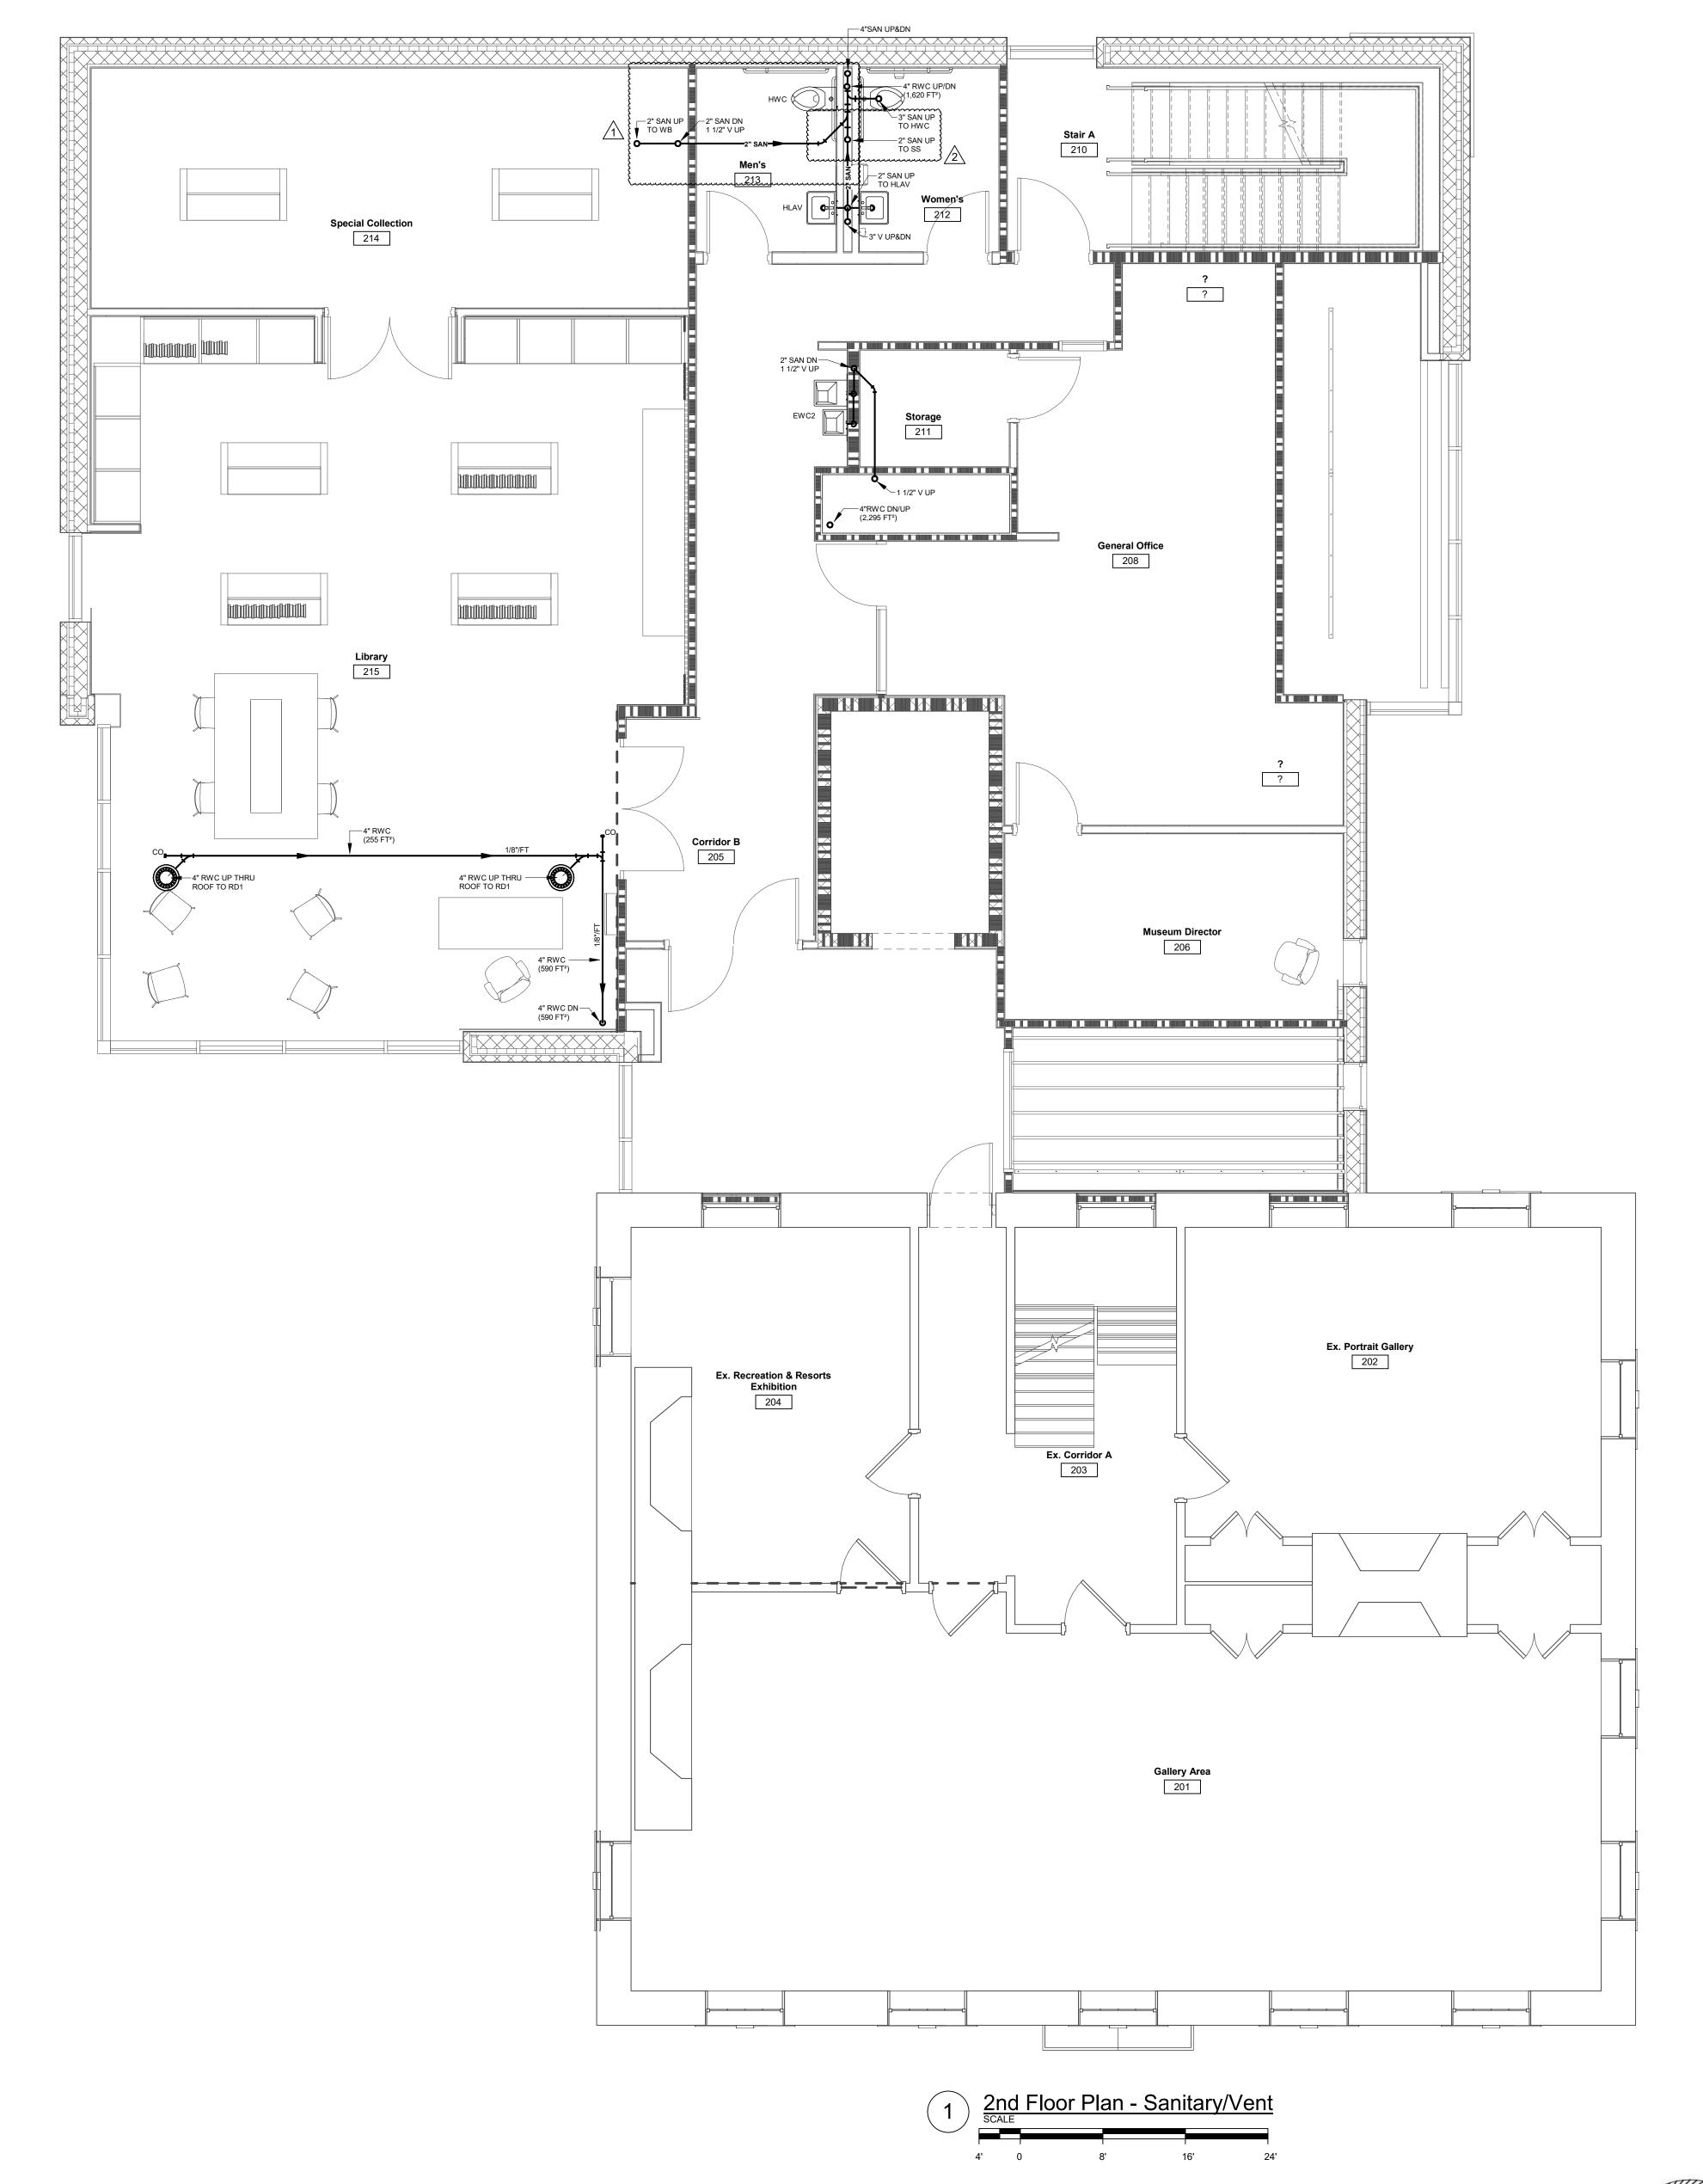



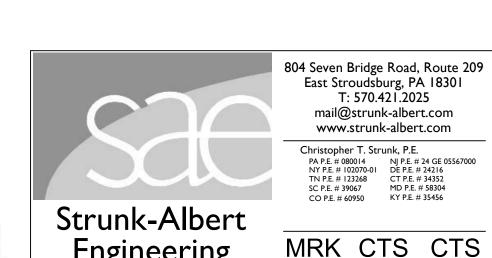

Christopher T. Strunk, P.E. Engineering
Engineered Systems and Building Consultants

MRK CTS CTS

designed checked checked drawing not valid without authorized sae signatures

PA P.E. # 080014 NJ P.E. # 24 GE 05567000 NY P.E. # 102070-01 DE P.E. # 24216 TN P.E. # 123268 CT P.E. # 34352 SC P.E. # 39067 MD P.E. # 58304 CO P.E. # 60950 KY P.E. # 35456

© MKSD, LLC www.mksdarchitects.com

architects Silvia A. Hoffman, AIA, LEED Todd O. Chambers, AIA, NCARB Jill P. Hewes, AIA, LEED AP Architecture Project Management MKSD, LLC 1209 Hausman Road Suite A Allentown, PA 18104 866.512.MKSD toll free 610.366.2081 phone 610.366.8399 fax

SIGNATURE

Association Iter Addition

Monroe County Historical As Alteration & Heritage Center Stroudsburg, 900 Main

01.26.23 - Issued for Permit 
 No.
 Date
 Description

 1
 02.07.23
 Addendum 1


 2
 02.16.23
 Addendum 2


DRAWING TITLE 2nd Floor Plan -Sanitary/Vent

> PROJECT NUMBER 16.200 DRAWN BY

MRK SCALE 1/4" = 1'-0"

DATE 01.26.23 DRAWING NUMBER

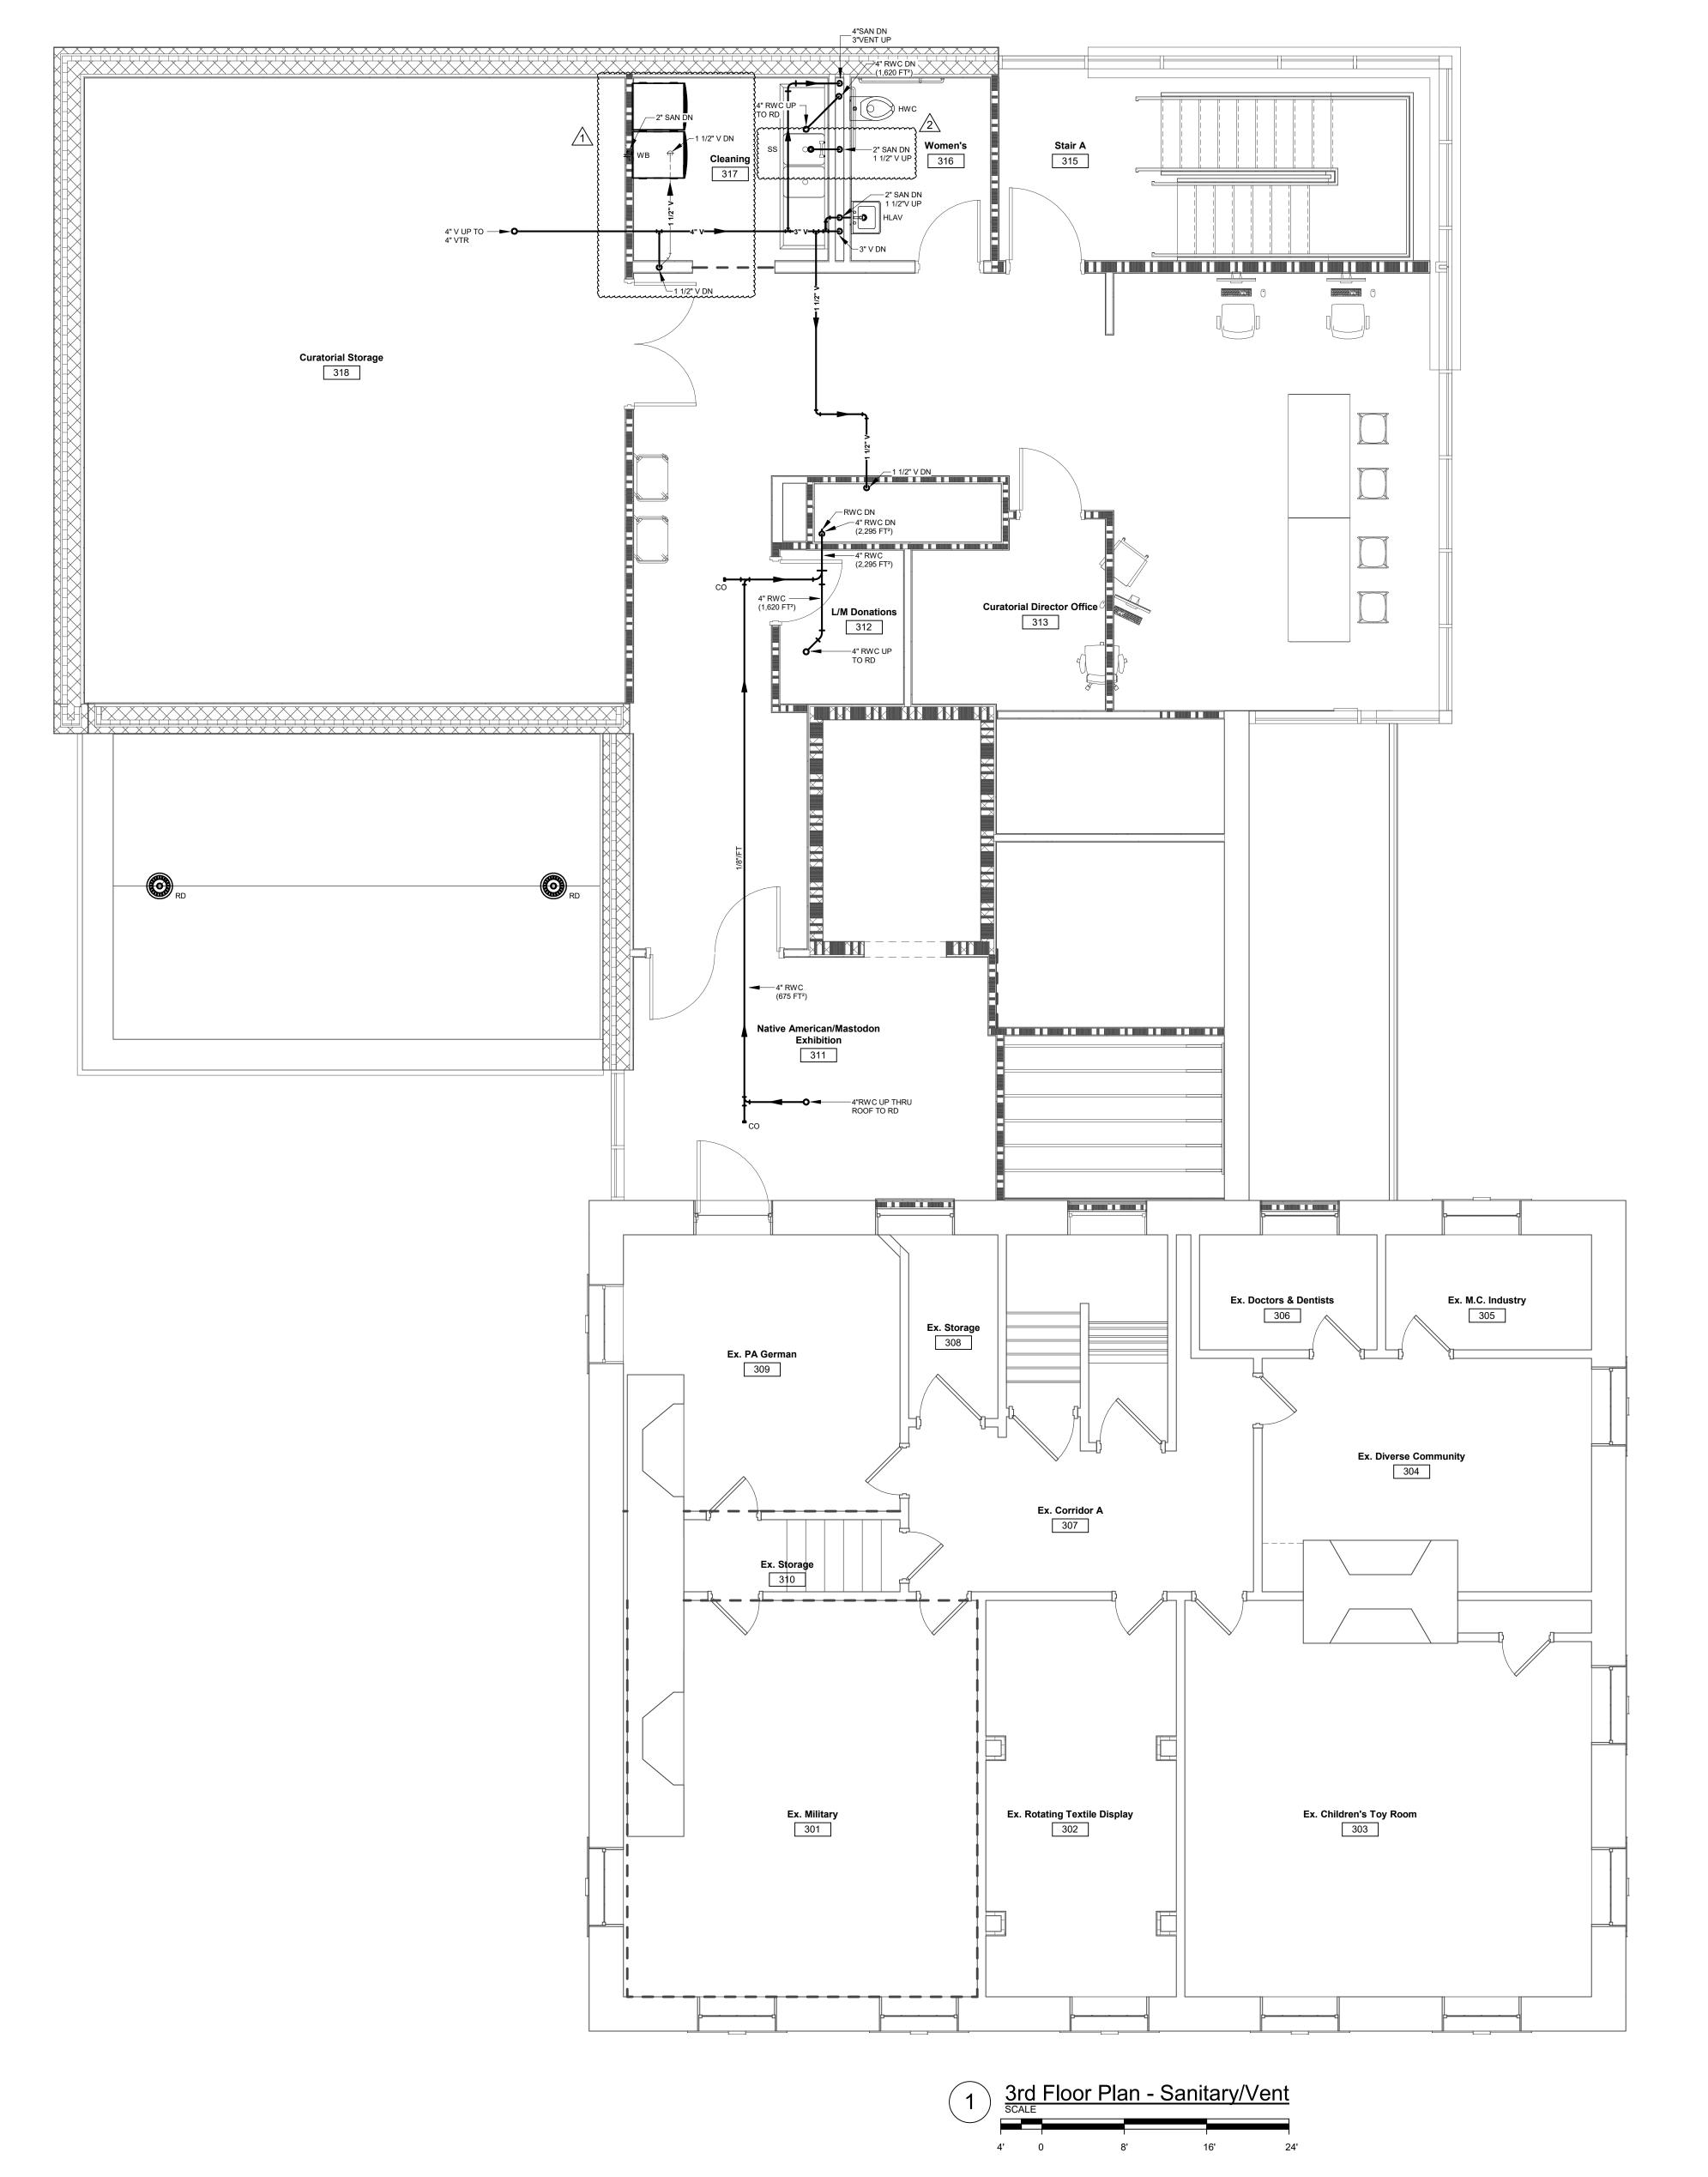

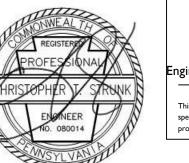



804 Seven Bridge Road, Route 209 East Stroudsburg, PA 18301 T: 570.421.2025 mail@strunk-albert.com www.strunk-albert.com Christopher T. Strunk, P.E. PA P.E. # 080014 NJ P.E. # 24 GE 05567000 NY P.E. # 102070-01 DE P.E. # 24216 TN P.E. # 123268 CT P.E. # 34352 SC P.E. # 39067 MD P.E. # 58304 CO P.E. # 60950 KY P.E. # 35456

Engineering
Engineered Systems and Building Consultants

MRK CTS CTS

drawn
drawn drawing not valid without authorized sae signatures This document is the sole propert and copyright of SAE for the specified project. Reproduction or use without authorization is

© MKSD, LLC

www.mksdarchitects.com

architects Silvia A. Hoffman, AIA, LEED

Todd O. Chambers, AIA, NCARB Jill P. Hewes, AIA, LEED AP Architecture

Project Management

MKSD, LLC 1209 Hausman Road Suite A Allentown, PA 18104

866.512.MKSD toll free 610.366.2081 phone 610.366.8399 fax

SIGNATURE

Monroe County Historical Association Heritage Center Addition

Stroudsburg, 900 Main

01.26.23 - Issued for Permit No.DateDescription102.07.23Addendum 1 2 02.16.23 Addendum 2

DRAWING TITLE


3rd Floor Plan -Sanitary/Vent


PROJECT NUMBER 16.200 DRAWN BY

DATE

MRK SCALE 1/4" = 1'-0"

01.26.23 DRAWING NUMBER

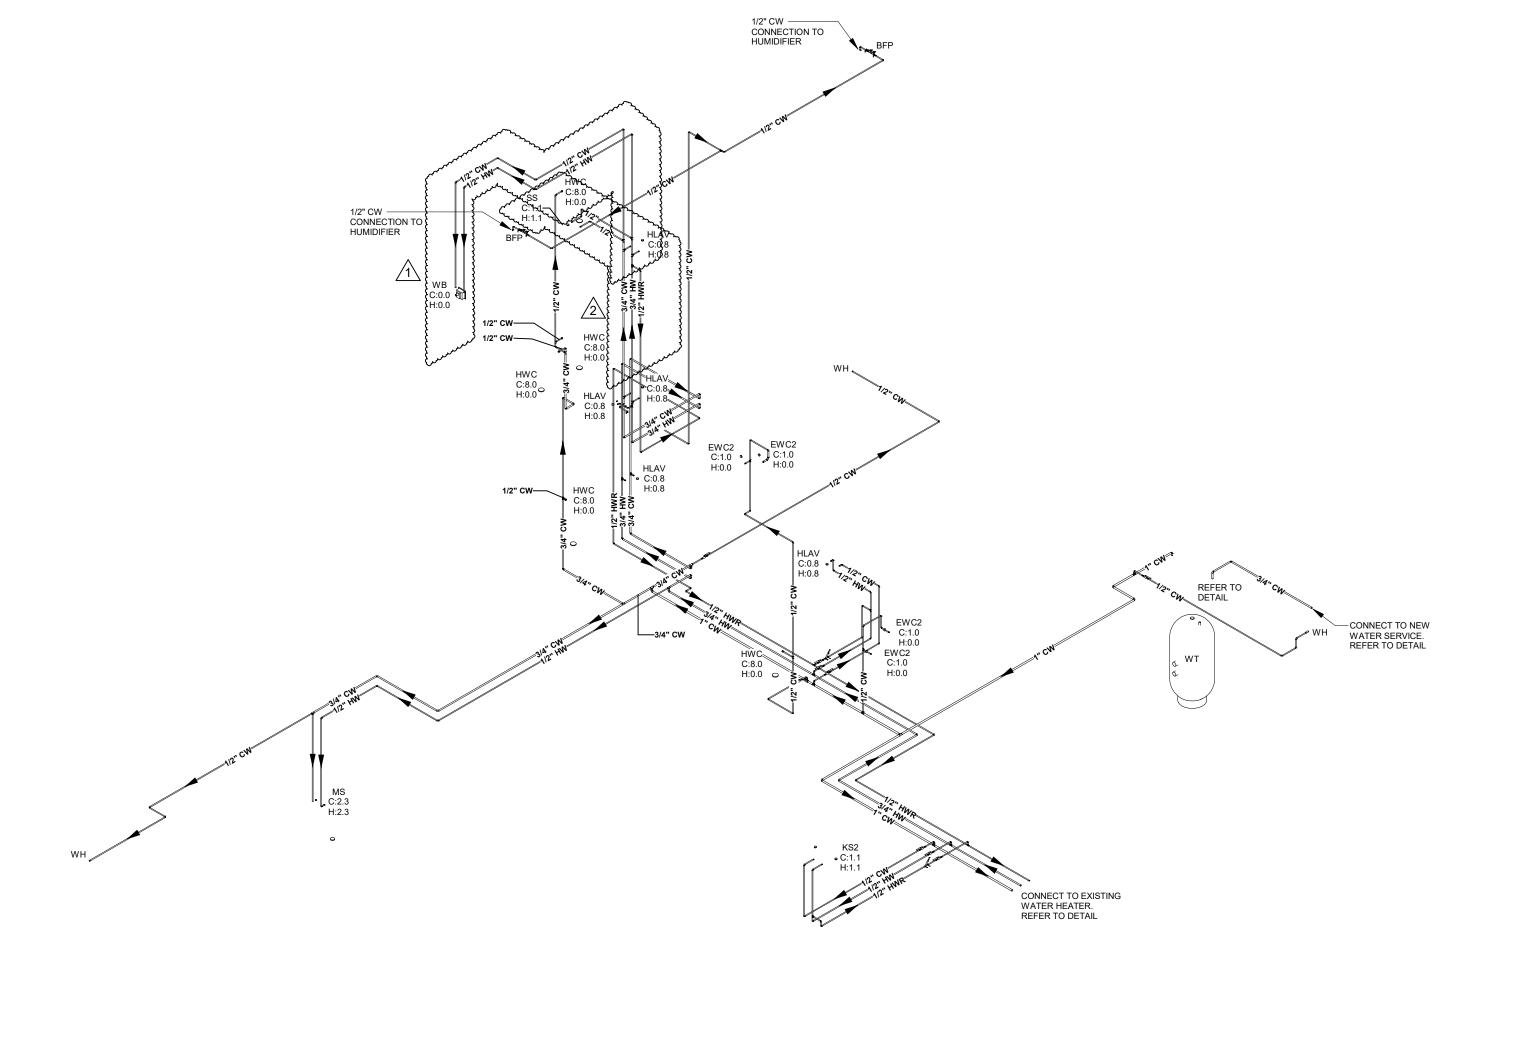


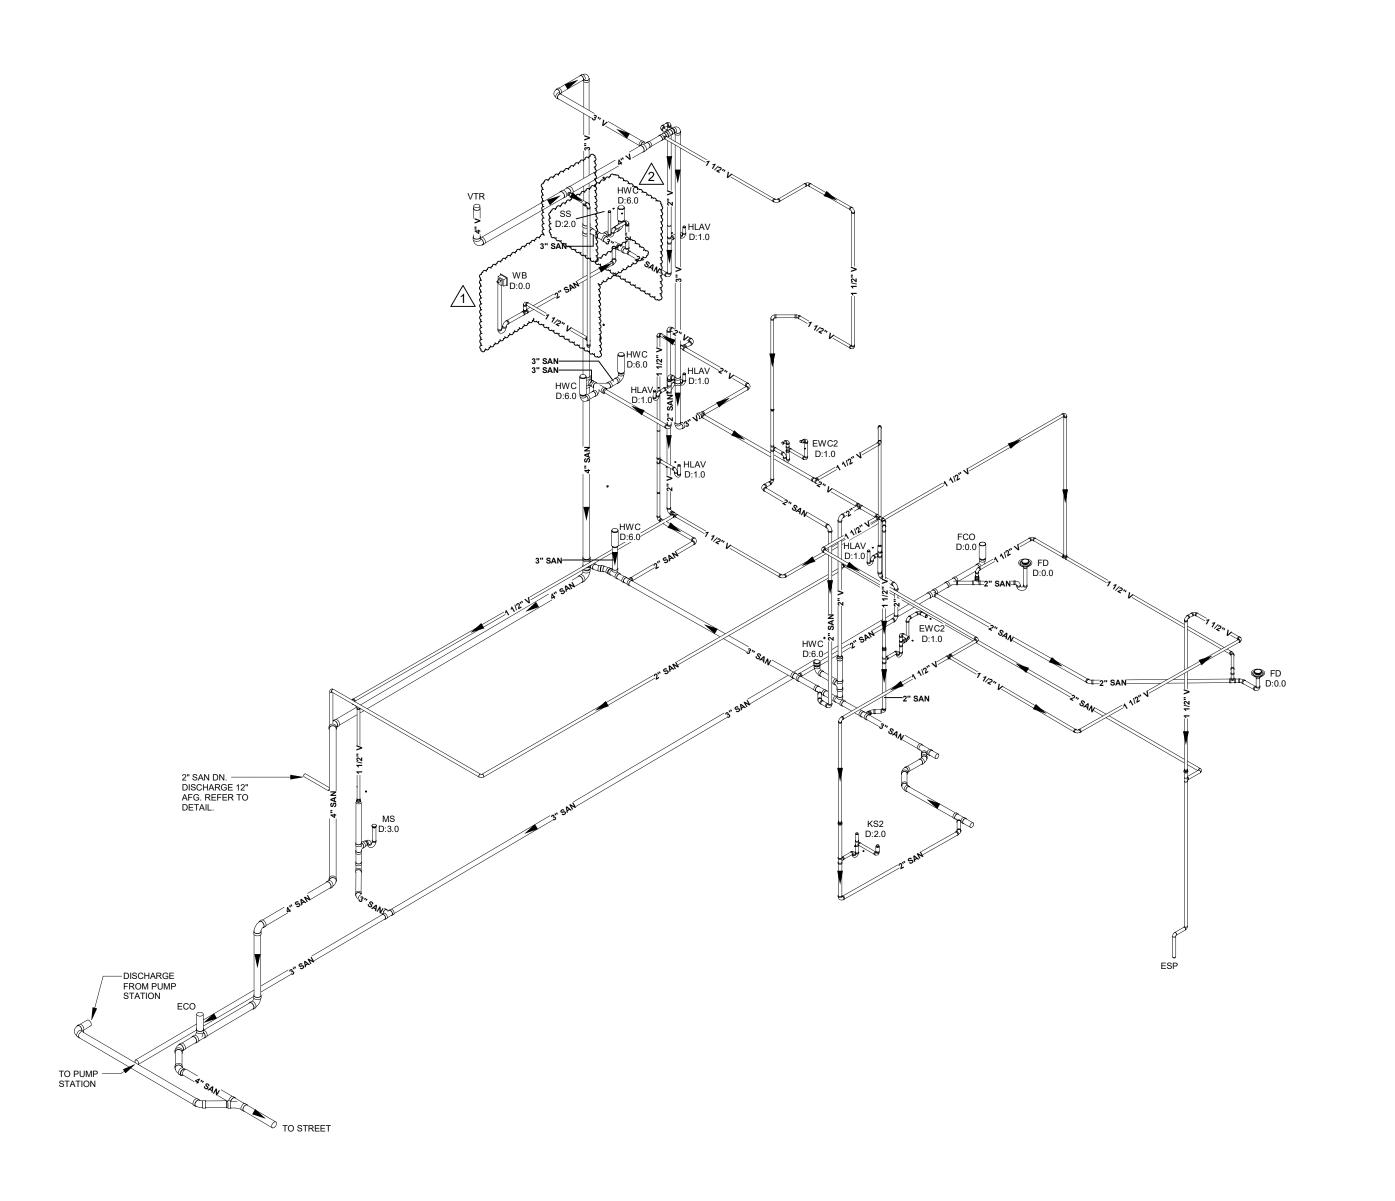

DOMESTIC WATER RISER DIAGRAM
NO SCALE

SANITARY/VENT RISER DIAGRAM
NO SCALE



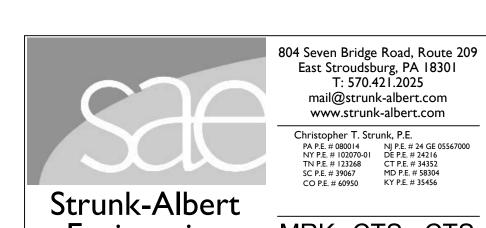

prohibited.

© MKSD, LLC

architects

Silvia A. Hoffman, AIA, LEED

AP Todd O. Chambers, AIA, NCARB Jill P. Hewes, AIA, LEED AP

Architecture Interiors Project Management

MKSD, LLC 1209 Hausman Road Suite A Allentown, PA 18104

866.512.MKSD toll free 610.366.2081 phone 610.366.8399 fax

SIGNATURE

Association Iter Addition

County Historical Ason & Heritage Center

Monroe CC substitution Alteration

01.26.23 - Issued for Permit

 No.
 Date
 Description

 1
 02.07.23
 Addendum 1

 2
 02.16.23
 Addendum 2

DRAWING TITLE

PROJECT NUMBER 16.200

MRK

01.26.23

DRAWN BY

SCALE

DATE

DETAILS

18360

900 Main Street

www.strunk-albert.com Christopher T. Strunk, P.E.

PA P.E. #080014 NJ P.E. #24 GE 05567000

NY P.E. # 102070-01 DE P.E. #24216

TN P.E. # 123268 CT P.E. #34352

SC P.E. #39067 MD P.E. #58304

CO P.E. # 60950 KY P.E. # 35456 DRAWING NUMBER Strunk-Albert
Engineering
Engineered Systems and Building Consultants

MRK CTS CTS

drawn designed checked drawing not valid without authorized sae signatures This document is the sole propert and copyright of SAE for the specified project. Reproduction or use without authorization is www.mksdarchitects.com

									PLUN	ИВING	FIXT	URE	SCHE	DULE					
FIXTURE	MANUFACTURER	TYPE	MODEL	TRIM NO.	SUPPORT NO.		MI	NIMUM PIPE S	SIZES			WSFU'S		DFU'S	FLOW RATE	MOUNTING	ELECTRICAL I	REQUIREMENTS	REMARKS
TIXTORE	WANDIAGICIALI	1112	WOBEL	Training.	OUT ON NO.	TRAP	WASTE	VENT	CW	HW	TOTAL	CW	HW	B100	TEOWIVALE	HEIGHTS	RECEPTACLE	JUNCTION BOX	THE WINTERS
HLAV	AMERICAN STANDARD	LUCERNE	0355.012	6055.205	JR SMITH 0700	1-1/4"	1-1/2"	1-1/4"	1/2"	1/2"	1.0	0.8	0.8	1.0	0.5 GPM	RIM AT 34" AFF	-	-	WALL HUNG LAVATORY WITH BATTERY POWERED SENSOR ACTIVATED FAUCET. PROVIDE WITH ASSE 1070 CERTIFIED DOWN TO 0.25 GPM MIXING VALVE SET OUTLET TEMPERATURE AT 105°F. LOCATE BELOW FIXTURE, INSTALLATION PER MANUFACTURERS INSTRUCTIONS. PROVIDE "TRUEBRO" PREFORMED LAV-GUARD INSULATION KIT, WHITE IN COLOR ON ALL EXPOSED PIPING UNDER SINKS. CAULK TO WALL.
HWC	AMERICAN STANDARD	CADET	2467.016 OR 4142.800		FLOOR	-	3" OR 4"	2"	1/2"										FLOOR MOUNTED ELONGATED PRESSURE ASSISTED SIPHON JET FLUSH ACTION TOILET WITH EVERCLEAN SURFACE AND BEMIS SEAT MODEL 1955SSTFR ELONGATED HEAVY DUTY OPEN FRONT LESS COVER WITH ANTIMICROBIAL SURFACE, CAULK TO FLOOR. ADA ONLYALL FLUSH HANDLES TO BE LOCATED ON THE TRANSFER SIDE OF ALL WATER CLOSETS, REGARDLESS OF WHAT IS SHOWN ON ALL PLANS AND BATHROOM ELEVATIONS.
MS	FIAT	MOLDED STONE MOP SINK	MSBID-2424	FIAT FAUCET 830AA	FLOOR	3"	3"	2"	3/4"	3/4"	-	-	-	-	-	MOUNT FAUCET 36" AFF	-	-	FAUCET WITH VACUUM BREAKER FAUCET, 832AA HOSE BRACKET, 889CC MOP HANGER, MSG2424 STAINLESS STEEL WALL GUARDS. SEAL TO WALL.
WHA-	JR SMITH	WATER HAMER ARRESTER	5000 SERIES	-	-	-	-	-	-	-	-	-	-	-	-	-	-	-	PDI-A=5005, PDI-B=5010, PDI-C=5020, PDI-D=5030, PDI-E=5040, PDI-F=5050
WH	JR SMITH	FREEZE PROOF WALL HYDRANT	5519-WC-NB	RECESSED BOX WITH LOCK	-	-	-	-	-	-	-	-	-	-	-	MOUNT AT 30" AFG	-	-	PROVIDE WITH VACUUM BREAKER. LENGTH BASED ON WALL THICKNESS TO WARM SIDE OF INSULATION, ADD ADDITIONAL 2" TO LENGTH FOR WALL CLAMP
FD	JR SMITH	FLOOR DRAIN	2010C-NB	-	FLOOR	2"	2"	1 1/2"	-	-	-	-	-	-	-	-	-	-	CAST IRON BODY, NICKEL BRONZE ADJUST, STRAINER, WITH AUX, INLET FITTING 2697C, AND TP
FD2	JR SMITH	FLOOR DRAIN	2130C-B-M	-	FLOOR	2"	3"	2"	-	-	-	-	-	-	-	-	-	-	CAST IRON BODY, DUCTILE IRON STRAINER, STRAINER, WITH AUX, INLET FITTING 2697C, AND TP
RD	JR SMITH	ROOF DRAIN	1020Y-R-C-CID	-	-	-	-	-	-	-	-	-	-	-	-	-	-	-	PIPE SIZE PER PLAN
FCO	JR SMITH	FLOOR CLEANOUT	4031-NB	-	-	-	-	-	-	-	-	-	-	-	-	-	-	-	PIPE SIZE PER PLAN, INSTALL LEVEL AND FLUSH WITH FINISHED FLOOR
ECO	JR SMITH	EXTERIOR CLEANOUT	4231-M	-	-	-	-	-	-	-	-	-	-	-	-	-	-	-	PIPE SIZE PER PLAN, INSTALL LEVEL AND FLUSH WITH CONCRETE
MV	POWERS	MIXING VALVE	ES-150	-	SEE REMARKS	-	-	-	1/2"	1/2"	-	-	-	-	-	-	-	-	LOCATE IN CONCEALED SPACE BELOW FIXTURE SET OUTLET TEMPERATURE AT 105°F, INSTALLATION PER MANUFACTURERS INSTRUCTIONS. ASSE 1070 RATED. PROVIDE FOR ALL HLAV AND KS2 SINKS
IMB	GUY GRAY	ICE MAKER BOX	BIM875	-	-	-	-	-	1/2"		-	-	-	-	-	BOTTOM OF BOX 12" AFF	-	-	16 GAUGE STEEL BOX WITH EPOXY FINISH
TD	JR SMITH	TRENCH DRAIN	9930	987-420-G GALV GRATE															
KS2	ELKAY	LUSTERTONE 3-HOLE	LR332265PD DOUBLE BOWL SINK	CHICAGO 2301-8CP	COUNTER	1 ½"	1 ½"	1 1/4"	1/2"	1/2"									7" BOWL DEPTH, LK-335 DUP STRAINER AND TAL PIECE CAULK TO COUNTER, DRAIN AND WATER PIPE ADA INSULATION KIT.
BFP-1	WATTS	RED. PRESSURE BACK. PREVENTER	LF007QTS						1/2"										NOTE: CONTRACTOR TO COORDINATE CERTIFICATION AND TESTING OF BACKFLOW PREVENTION DEVICE WITH AN APPROVED PA CERTIFIED TESTER.
BFP-2	WATTS	DOUBLE CHECK BACKFLOW PREVENTER	007						3/4"										
EP	LIBERTY PUMPS	EFFLUENT PUMP	***************************************	***************************************	······		······································	***************************************	<del>,,,,,,,,,,,,,,,,,,,,,,,,,,,,,,,,,,,,,</del>	·~~~~~~					······································	······································	~~~~~~~~~~	120 V 1/2 HP	30"X144" FIBERGLASS SIMPLEX SUMP PUMP WITH GASKETED LID. (1) 280-2 SUMP PUMP 120V, SHUT-OFF HEAD OF 37' AND 3/4" SOLIDS HANDLING CAPABILITY. PROVIDE WITH SXL24=3 CONTROL PANEL, NEMA-4, HIGH LEVEL ALARM. CONNECT AUX ALARM OUTPUT TO INPUT OF SP NIGHTEYE PANEL. PROVIDE WITH INTERNAL PIPING, GUIDE RAIL, JUNCTION BOX AND
SP	LIBERTY PUMPS	SUMP PUMP																120V 1/2 HP	LIBERTY SUBMERSIBLE EFFLUENT PUMP 287 1/2 HP, 1 PHASE, 120V, 24"X36" FIBERGLASS SUMP PIT AND BLANK COVER WITH GASKET AND HARDWARE. SYSTEM TO BE SUITABLE FOR FOOT TRAFFIC. ALL WIRING TO BE RUN UNDERGROUND. PRE-ASSEMBLED WITH 1-1/2" SCHEDULE 40 PVC DISCHARGE PIPE. MOLDED PUMP SUPPORT PLATFORM RAISES PUMP OFF BOTTOM OF PIT AND HELPS SECURE PUMP DURING SHIPPING. TWO 4" INLET HUBS WITH RUBBER GROMMET SEALS PROVIDED. GASKET SEALED COVER - RADON READY. NIGHT EYE WIRELESS WITH LOCAL HIGH LEVEL ALARM. BATTERY BACK-UP PUMP READY. PLATFORM DESIGNED TO PROPERLY LOCATE A LIBERTY PUMPS 442-10A-EYE BACK-UP SUMP PUMP SYSTEM.
ESP	STANCOR	ELEVATOR SUMP	SE-50		<u> </u>		2"		<del></del>						haran and a second	<u> </u>	u	<u> </u>	1/2 HP, 115V/1PH, 3600 RPM, INSTALLATION PER MANUFACTURERS SPECIFICATIONS
WB	WATTS	WASHING MACHINE BOX WITH AUTO SHUTOFF	A2C-WB-M1		RECESSED WALL MOUNT	2"	2"	1-1/2"	1/2"	1/2"	-					BOTTOM OF BOX @ 45" AFF		115V, 15A GFI	PROVIDE WITH WATTS INTELLIFLOW AUTOMATIC WASHING MACHINE WATER SHUTOFF VALVE WITH RECESSED WALL BOX AND LEAK SENSOR LOCATED AT THE BASE OF THE WASHER. FOR 240 V INSTALLATIONS, PROVIDE WATTS A2 INTELITIMER ACCESSORY.
SS	REGENCY	TWO COMPARTMENT SINK	600S218242X	WATERLOO 750PRWL812LF	FREE STANDING	1 ½"	1 ½"	1 1/4"	1/2"	1/2"		***************************************		***************************************	***************************************		***************************************		16 GAUGE, 304 STAINLESS STEEL CONSTRUCTION WITH DOUBLE 24" DRAINBOARDS. PROVIDE WITH BASKET STRAINER AND LEGS.
CENEDAL NOTE			<del></del>	<del></del>	<del>~~~~~~~~~~~~~~~~~~~~~~~~~~~~~~~~~~~~~</del>	<u>,,,,,,,,,,,,,,,,,,,,,,,,,,,,,,,,,,,,,</u>	<u> </u>	<del>~~~~~~~</del>	<u>,,,,,,,,,,,,,,,,,,,,,,,,,,,,,,,,,,,,,</u>		PECIEIC NOT		<u> </u>	<del></del>	······································	<u> </u>	<del>mmmmm</del>	<u></u>	

GENERAL NOTES:

1. ALL CHINA FIXTURES TO BE SUPPLIED WHITE.

 ALL EXPOSED PIPING TO BE CHROMED PLATED.
 PROVIDE STOP VALVES AT EACH FIXTURE. 4. ADJUST ALL SELF CLOSING FAUCETS FOR 10 SECOND RUN TIME.

5. FURNISH ALL LAVATORIES WITH CHROME PLATED METAL GRID STRAINER AND TAILPIECE. 6. EXPOSED P-TRAPS FOR LAVS TO BE 1 1/4" X 1 1/2" 17 GAUGE CHROME PLATED WITH CLEANOUTS.

7. ENGINEERS APPROVED EQUALS BY OTHERS ARE ALSO ACCEPTED.

8. ALTERNATE MANUFACTURERS KOHLER, CRANE, WADE, AND ZURN. 9. PROVIDE WITH PROSET SYSTEMS TRAP GUARD FOR ALL ADA SINKS

10. FOR SUMP PUMPS PROVIDE WITH ALL NECESSARY FITTINGS, CHECK VALVES, BALL VALVES, TANK, BASIN COVER, DUPLEX CONTROL PANEL, DISCONNECTS, AND ALARM DEVICE. FINAL ELECTRICAL CONNECTION BY EC. INSTALLATION PER MANUFACTURERS SPECIFICATIONS.

FIXTURE SPECIFIC NOTES:

A. ALL FLUSH HANDLES TO BE LOCATED ON THE TRANSFER SIDE OF ALL WATER CLOSETS, REGARDLESS OF WHAT IS SHOWN ON ALL PLANS AND BATHROOM ELEVATIONS

B. PROVIDE "TRUEBRO" PREFORMED LAV-GUARD INSULATION KIT, WHITE IN COLOR ON ALL EXPOSED PIPING UNDER SINKS.
C. FURNISHED SERVICE SINK MOP BASIN WITH STAINLESS STEEL CURB CAPS, HOSE BRACKET #832-AA, MOP HANGER #889-CC, STAINLESS STEEL WALL GUARDS CAULKED WITH #833-AA. D. PROVIDE RD/ORD WITH SUMP RECEIVER, UNDER DECK CLAMPS, CAST IRON DOME, STAINLESS STEEL GRAVEL GUARD AND EXTENSION COLLARS, PIPE SIZE AS PER PLAN.

E. PROVIDE WITH FLOOR DRAINS WITH JR SMITH QUAD CLOSE TRAP SEAL DEVICE MODEL 2692.

F. FURNISHED SERVICE SINK MOP BASIN WITH STAINLESS STEEL CURB CAPS, HOSE BRACKET #832-AA, MOP HANGER #889-CC, STAINLESS STEEL WALL GUARDS CAULKED WITH #833-AA. G. PROVIDE ELEVATOR SUMP PUMP WITH ALL NECESSARY FITTINGS, CHECK VALVE, BALL VALVE, CONTROL PANEL, DISCONNECT, AND ALARM DEVICE.

mail@strunk-albert.com www.strunk-albert.com Christopher T. Strunk, P.E.

PA P.E. # 080014 NJ P.E. # 24 GE 05567000

NY P.E. # 102070-01 DE P.E. # 24216

TN P.E. # 123268 CT P.E. # 34352

SC P.E. # 39067 MD P.E. # 58304

CO P.E. # 60950 KY P.E. # 35456

DRAWING NUMBER

© MKSD, LLC www.mksdarchitects.com

architects

Silvia A. Hoffman, AIA, LEED

Todd O. Chambers, AIA, NCARB Jill P. Hewes, AIA, LEED AP

Architecture

Interiors Project Management

MKSD, LLC 1209 Hausman Road

Allentown, PA 18104

866.512.MKSD toll free 610.366.2081 phone 610.366.8399 fax

Suite A

SIGNATURE

Association er Addition

REVISIONS

DRAWING TITLE

SCHEDULES

PROJECT NUMBER 16.200

MRK

1/8" = 1'-0"

01.26.23

DRAWN BY

SCALE

DATE

01.26.23 - Issued for Permit


02.07.23 Addendum 1

2 02.16.23 Addendum 2

804 Seven Bridge Road, Route 209 East Stroudsburg, PA 18301 T: 570.421.2025 Strunk-Albert
Engineering
Engineered Systems and Building Consultants

MRK CTS CTS

drawn designed checked drawing not valid without authorized sae signatures This document is the sole propert and copyright of SAE for the specified project. Reproduction or use without authorization is

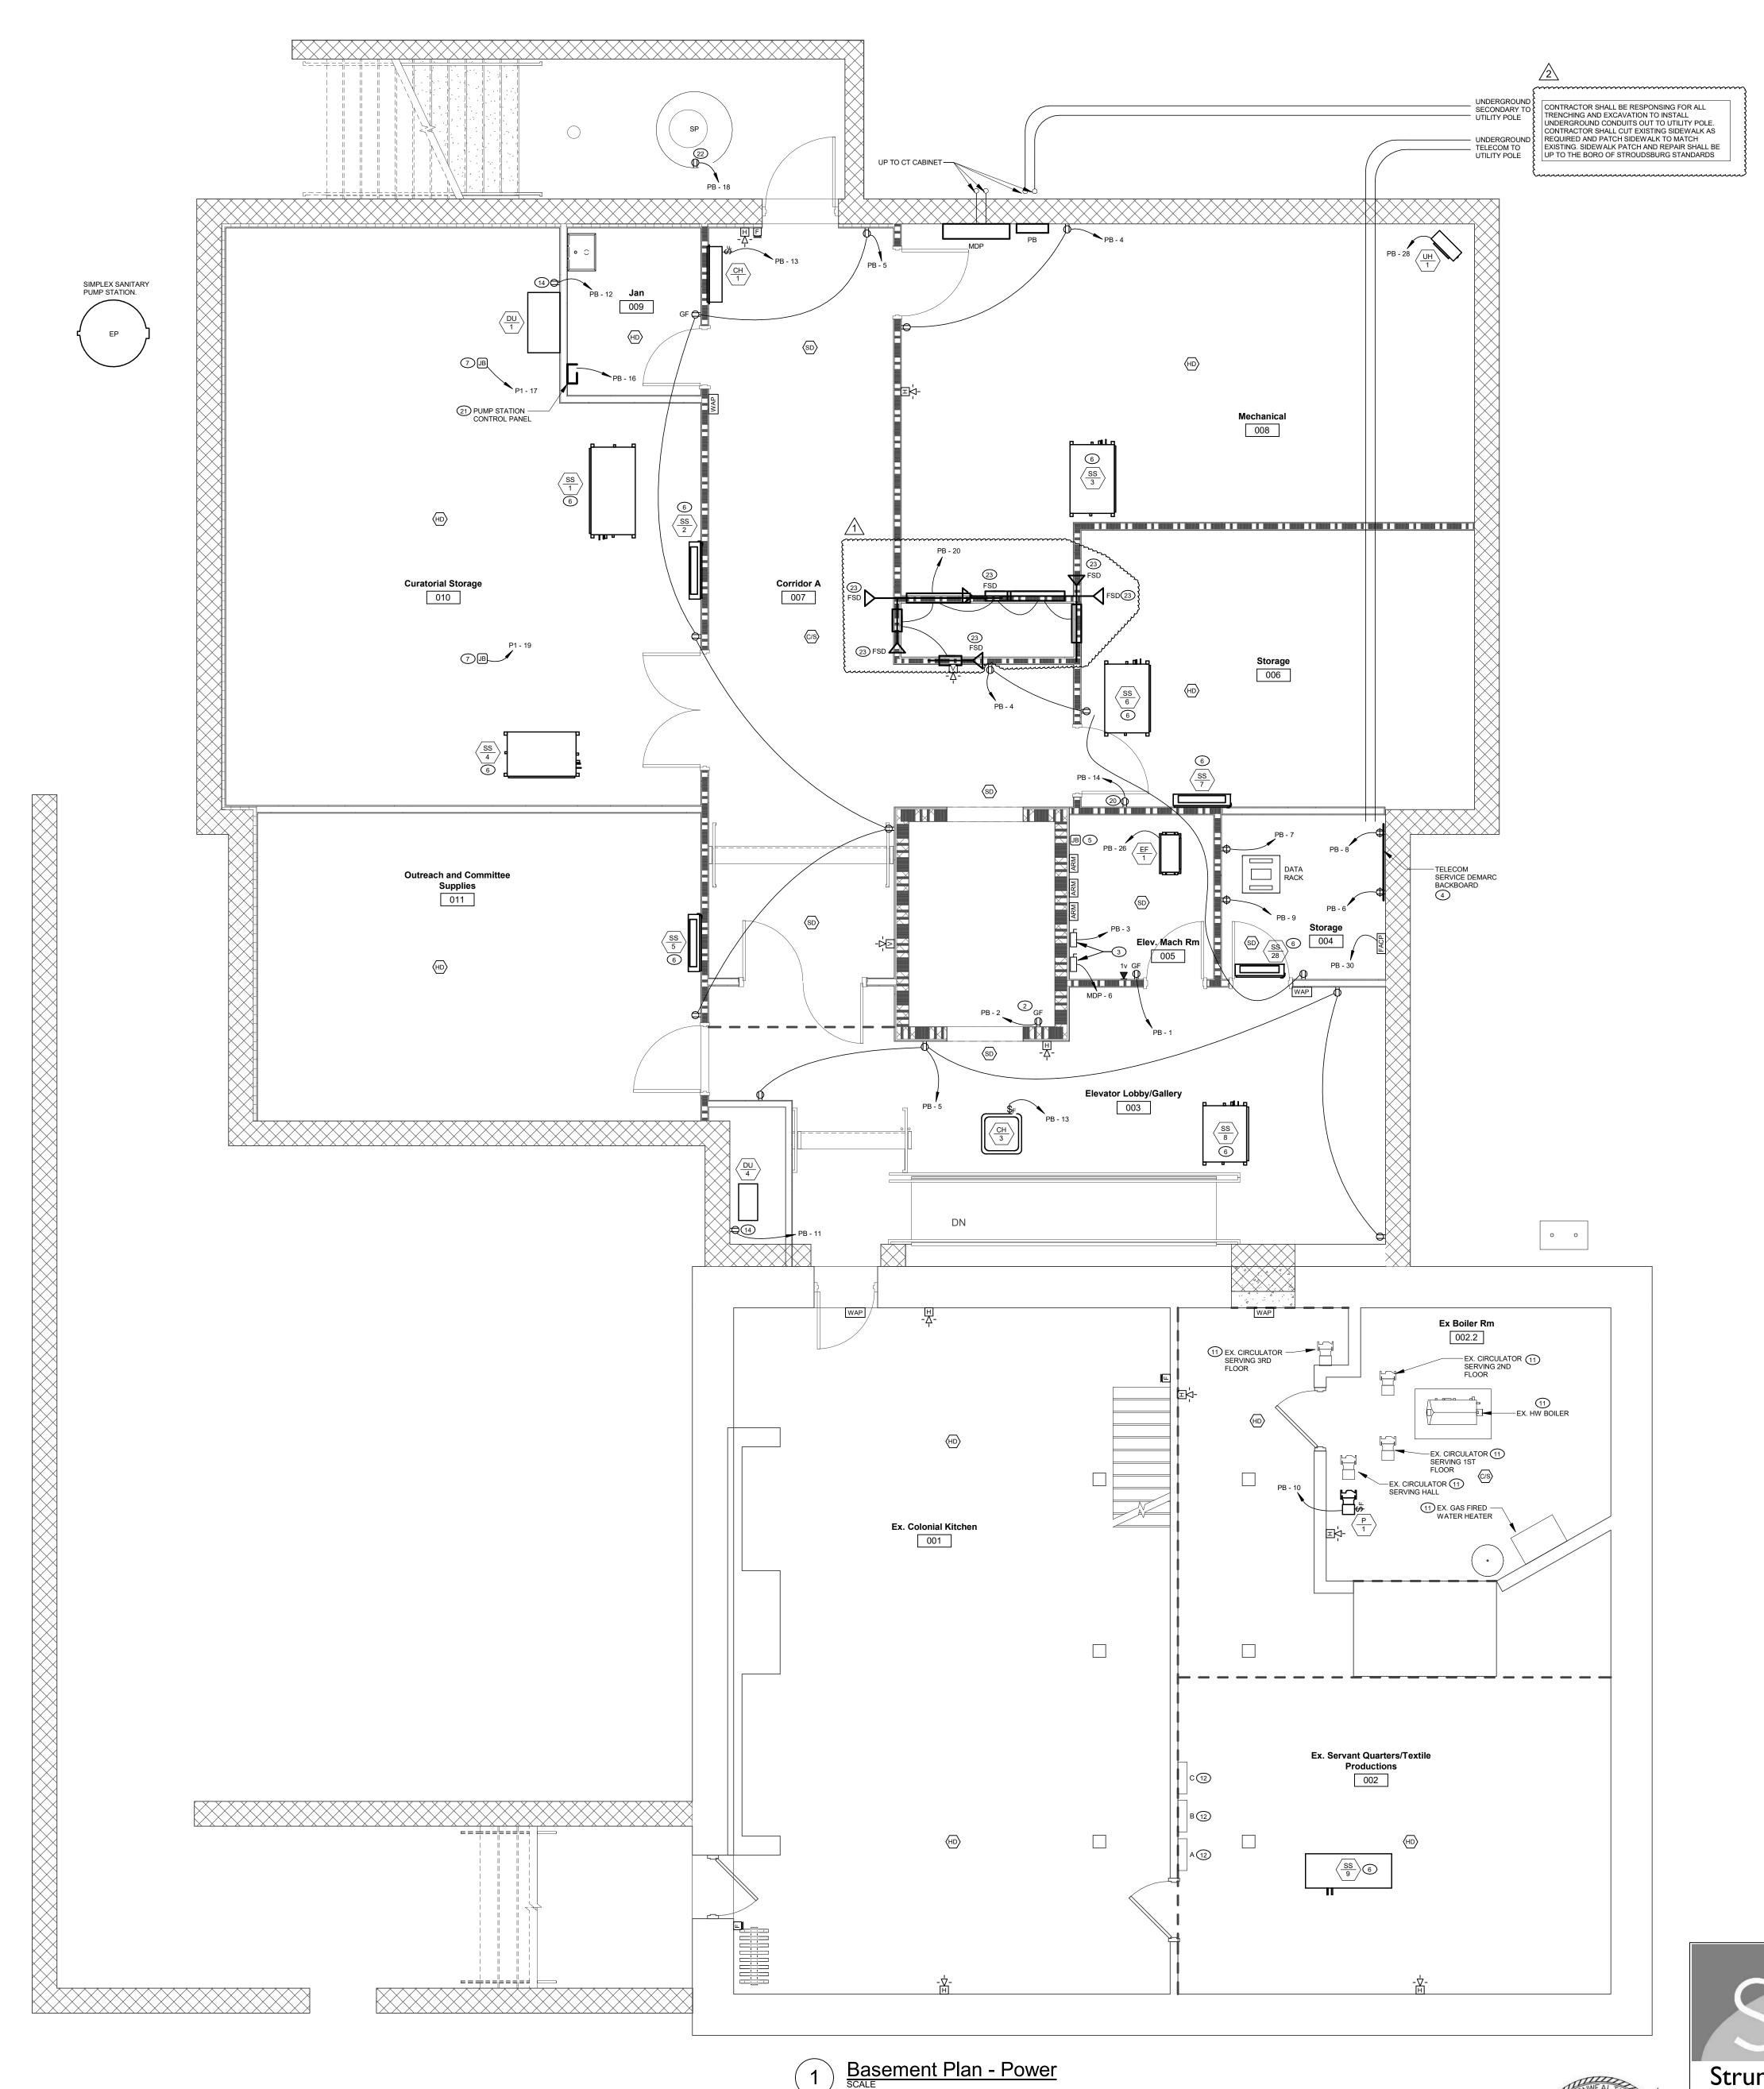

INTRUSION DETECTION SYSTEM WILL BE PROVIDED UNDER SEPARATE CONTRACT BY THE OWNER. OWNERS VENDOR WILL BE WORKING ON SITE

BUILDING ACCESS WITH VENDOR

AT SAME TIME AS CONTRACT. CONTRACTOR SHALL COORDINATE SITE AND

**NEW WORK NOTES BY SYMBOL - ELECTRIC** 

- 1 WATER COOLER: PROVIDE DUPLEX GROUND FAULT RECEPTACLE FOR WATER COOLER. CONCEAL RECEPTACLE BELOW/BEHIND
- MOUNTING BOX OF COOLER. 2 REFER TO ELEVATOR PIT LIGHT DETAIL.
- (3) REFER TO ELEVATOR POWER AND CONTROL WIRING DIAGRAM.
- 4 TELECOM DEMARC: PROVIDE 3/4"X6'X4"H PAINTED TREATED CDX PLYWOOD BACKBOARD FOR TELEPHONE AND COMMUNICATIONS HEADEND EQUIPMENT PROVIDED BY UTILITY COMPANIES.
- (5) ELEVATOR PHONE LINES: PROVIDE CAT. 6 CABLES FROM ELEVATOR EQUIPMENT TO TELEPHONE DEMARC LOCATION. VERIFY EXACT QUANTITY AND TERMINATION LOCATION WITH ELEVATOR INSTALLER.
- (6) SPLIT SYSTEM: PROVIDE NEMA 3R DISCONNECT SWITCH FOR OUTDOOR UNIT. PROVIDE CONDUIT AND WIRING, AS PER PANEL SCHEDULE, FROM PANEL INDICATED TO OUTDOOR UNIT DISCONNECT SWITCH. PROVIDE FINAL ELECTRICAL CONNECTION TO OUTDOOR UNIT. PROVIDE POWER AND CONTROL CONDUIT AND WIRING, AS REQUIRED BY MANUFACTURER, FROM OUTDOOR UNIT TO INDOOR UNIT. INDOOR UNIT TO BE POWERED FROM OUTDOOR UNIT. PROVIDE FINAL ELECTRICAL CONNECTION TO INDOOR UNIT. COORDINATE ALL WORK WITH SPLIT SYSTEM INSTALLER. PROVIDE CIRCUIT BREAKER LOCKING DEVICE, FOR SPLIT SYSTEM CIRCUIT BREAKER, TO MEET THE REQUIREMENTS
- 7) FUTURE FLOOR BOX POWER: PROVIDE JUNCTION BOX FOR FUTURE POWER TO FUTURE FLOOR BOX. PROVIDE CONDUIT AND WIRING, AS INDICATED, FROM JUNCTION BOX TO PANEL INDICATED. CAP WIRES INJUNCTION BOX AND LABEL "FUTURE FLOOR BOX". PROVIDE CIRCUIT BREAKER LOCKING DEVICE TO LOCK BREAKER IN THE OFF POSITION.
- 8 REFER TO TV OUTLET MOUNTING DETAIL.
- 9 DESTRAT FAN: PROVIDE SINGLE RECEPTACLE IN SURFACE CAST BOX MOUNTED ADJACENT TO DESTRAT FAN. COORDINATE EXACT LOCATION WITH FAN INSTALLER.
- (10) TRACK LIGHTING: PROVIDE SEPARATE LIGHTING FOR CONTROL OF TRACK LIGHTING. COORDINATE EXACT CONTROL LOCATION WITH OWNER PRIOR TO ROUGH-IN.
- (11) EXISTING, SHOWN FOR COORDINATION.
- EXISTING PANEL: PROVIDE NEW FEEDER CONDUIT AND CONDUCTORS, AS PER RISER DIAGRAM, FROM EXISTING PANEL BACK TO NEW MDP.
- (13) KITCHEN HOOD: INSTALL ELECTRICAL DISCONNECT THAT COMES WITH HOOD. PROVIDE CONDUIT AND WIRING FROM DISCONNECT BACK TO PANEL INDICATED. PROVIDE ALL CONDUIT AND WIRING AND FINAL ELECTRICAL CONNECTION FROM DISCONNECT TO HOOD. PROVIDE ALL INTERCONNECTING CONDUIT AND WIRING BETWEEN HOOD AND FAN.
- (14) DEHUMIDIFICATION UNIT: PROVIDE DUPLEX RECEPTACLE FOR USE WITH DEHUMIDIFICATION UNIT. COORDINATE EXACT LOCATION WITH UNIT INSTALLER.
- 15) STRING LIGHTING: PROVIDE WP GF RECEPTACLE FOR USE WITH OWNER PROVIDED STRING LIGHTING. COORDINATE EXACT RECEPTACLE MOUNTING HEIGHT AND LOCATION WITH OWNER PRIOR TO ROUGH-IN.
- (16) TAPE LIGHT: PROVIDE TIVOLI TPLE-SB-O-30-24 TAPE LIGHT IN MOFT-CHAN-SLV-6.5 MOUNTING CHANNEL WITH MOFT-LNS-OPL-6.5 LENS. CHANNEL SHALL BE RECESSED IN NEW SITE WALL. COORDINATE INSTALLATION WITH ARCHITECTURAL DRAWINGS. PROVIDE LENGTHS OF TAPELIGHT AND MOUNTING CHANNEL AS REQUIRED TO EXTEND AROUND ENTIRE WALL AS INDICATED. PROVIDE ADNM-320-3-4-24-D POWER SUPPLY FOR TAPELIGHT. PROVIDE ALL WIRING, AS PER MANUFACTURER, FROM TRANSFORMER TO SECTIONS OF TAPELIGHT AS REQUIRED TO NOT OVERLOAD POWER SUPPLY.
- (17) REFER TO EXTERIOR LIGHTING CONTROL DIAGRAM.
- (18) EXTERIOR WALL WASH: PROVIDE NEW LUMINAIRE AS INDICATED. CONNECT NEW LUMINAIRE TO EXISTING CONDUIT AND WIRING REMAINING FROM REMOVAL OF EXISTING LUMINAIRE. PROVIDE CONDUIT AND WIRING, FROM JUNCTION BOX, PROVIDED AS PER DEMOLITION NOTES BY SYMBOL, TO CIRCUIT INDICATED. WIRE THROUGH RELAY PANEL AS REQUIRED.
- 19 POST TOP LUMINAIRE: REFER TO CIVIL DRAWINGS FOR POST TOP LUMINAIRE SPECIFICATIONS AND POLE BASE INFORMATION. PROVIDE CONDUIT AND WIRING, AS INDICATED, FROM LUMINAIRE TO CIRCUIT INDICATED. PROVIDE DUAL-LITE LPS-55-S-RTSLP EMERGENCY LIGHTING INVERTER FOR POWERING LUMINAIRE DURING NORMAL POWER INTERRUPTION. PROVIDE ALL WIRING, AS PER MANUFACTURER, BETWEEN POWER SOURCE, EXTERIOR LIGHTING RELAY PANEL, INVERTER AND LUMINAIRE AS REQUIRED.
- 20 ELEVATOR SUMP PUMP: PROVIDE DUPLEX RECEPTACLE FOR ELEVATOR SUMP PUMP. MOUNT RECEPTACLE ADJACENT TO SUMP PUMP CONTROL PANEL.
- 21) EJECTOR PUMP: PROVIDE CONDUIT AND WIRING, AS INDICATED, FROM EJECTOR PUMP CONTROL PANEL TO CIRCUIT INDICATED. PROVIDE FINAL ELECTRICAL CONNECTION TO PUMP CONTROL
- (22) SUMP PUMP: PROVIDE DUPLEX GF RECEPTACLE IN SURFACE CAST BOX FOR SUMP PUMP. MOUNT RECEPTACLE IN SUMP PUMP
- BASIN. COORDINATE ALL WORK WITH SUMP PUMP INSTALLER. (23) FIRE/SMOKE DAMPER: PROVIDE JUNCTION BOX FOR POWER CONNECTION TO FIRE/SMOKE DAMPER ACTUATOR. PROVIDE FIRE ALARM ADDRESSABLE MODULE FOR SMOKE DAMPER. PROVIDE TOGGLE SWITCH FOR TESTING OF DAMPER. PROVIDE CONDUIT AND WIRING, AS PER PANEL SCHEDULE, FROM PANEL INDICATED THROUGH SWITCH, FIRE ALARM MODULE AND JUNCTION BOX TO SMOKE DAMPER ACTUATOR MOTOR. PROVIDE FINAL ELECTRICAL CONNECTIONS TO ALL ITEMS AS REQUIRED. COORDINATE ALL

WORK WITH FIRE ALARM SYSTEM INSTALLER AND SMOKE DAMPER INSTALLER. MOUNT TOGGLE SWITCH AND ADDRESSABLE MODULE IN LOCATION DETERMINED BY OWNER. REFER TO

FIRE/SMOKE DAMPER & DUCT DETECTOR DETAIL

804 Seven Bridge Road, Route 209 East Stroudsburg, PA 18301 T: 570.421.2025 mail@strunk-albert.com www.strunk-albert.com Christopher T. Strunk, P.E. PA P.E. # 080014 NJ P.E. # 24 GE 05567000 NY P.E. # 102070-01 DE P.E. # 24216 TN P.E. # 123268 CT P.E. # 34352 SC P.E. # 39067 MD P.E. # 58304 CO P.E. # 60950 KY P.E. # 35456 Strunk-Albert

Engineered Systems and Building Consultants drawn designed checked drawing not valid without authorized sae signatures This document is the sole propert and copyright of SAE for the

SAE Project No: FHC-14619 specified project. Reproduction or use without authorization is

architects

Silvia A. Hoffman, AIA, LEED Todd O. Chambers, AIA, Jill P. Hewes, AIA, LEED AP

Architecture Project Management

MKSD, LLC 1209 Hausman Road Suite A

Allentown, PA 18104 866.512.MKSD toll free 610.366.2081 phone 610.366.8399 fax

SIGNATURE

**=** 

900

REVISIONS 01.26.23 - Issued for Permit

02.07.23 Addendum 1

02.16.23 Addendum 2

DRAWING TITLE Basement Plan -


PROJECT NUMBER 16.200

DRAWN BY JRP SCALE

DRAWING NUMBER

As indicated DATE 01.26.23

c) MKSD, LLC www.mksdarchitects.com

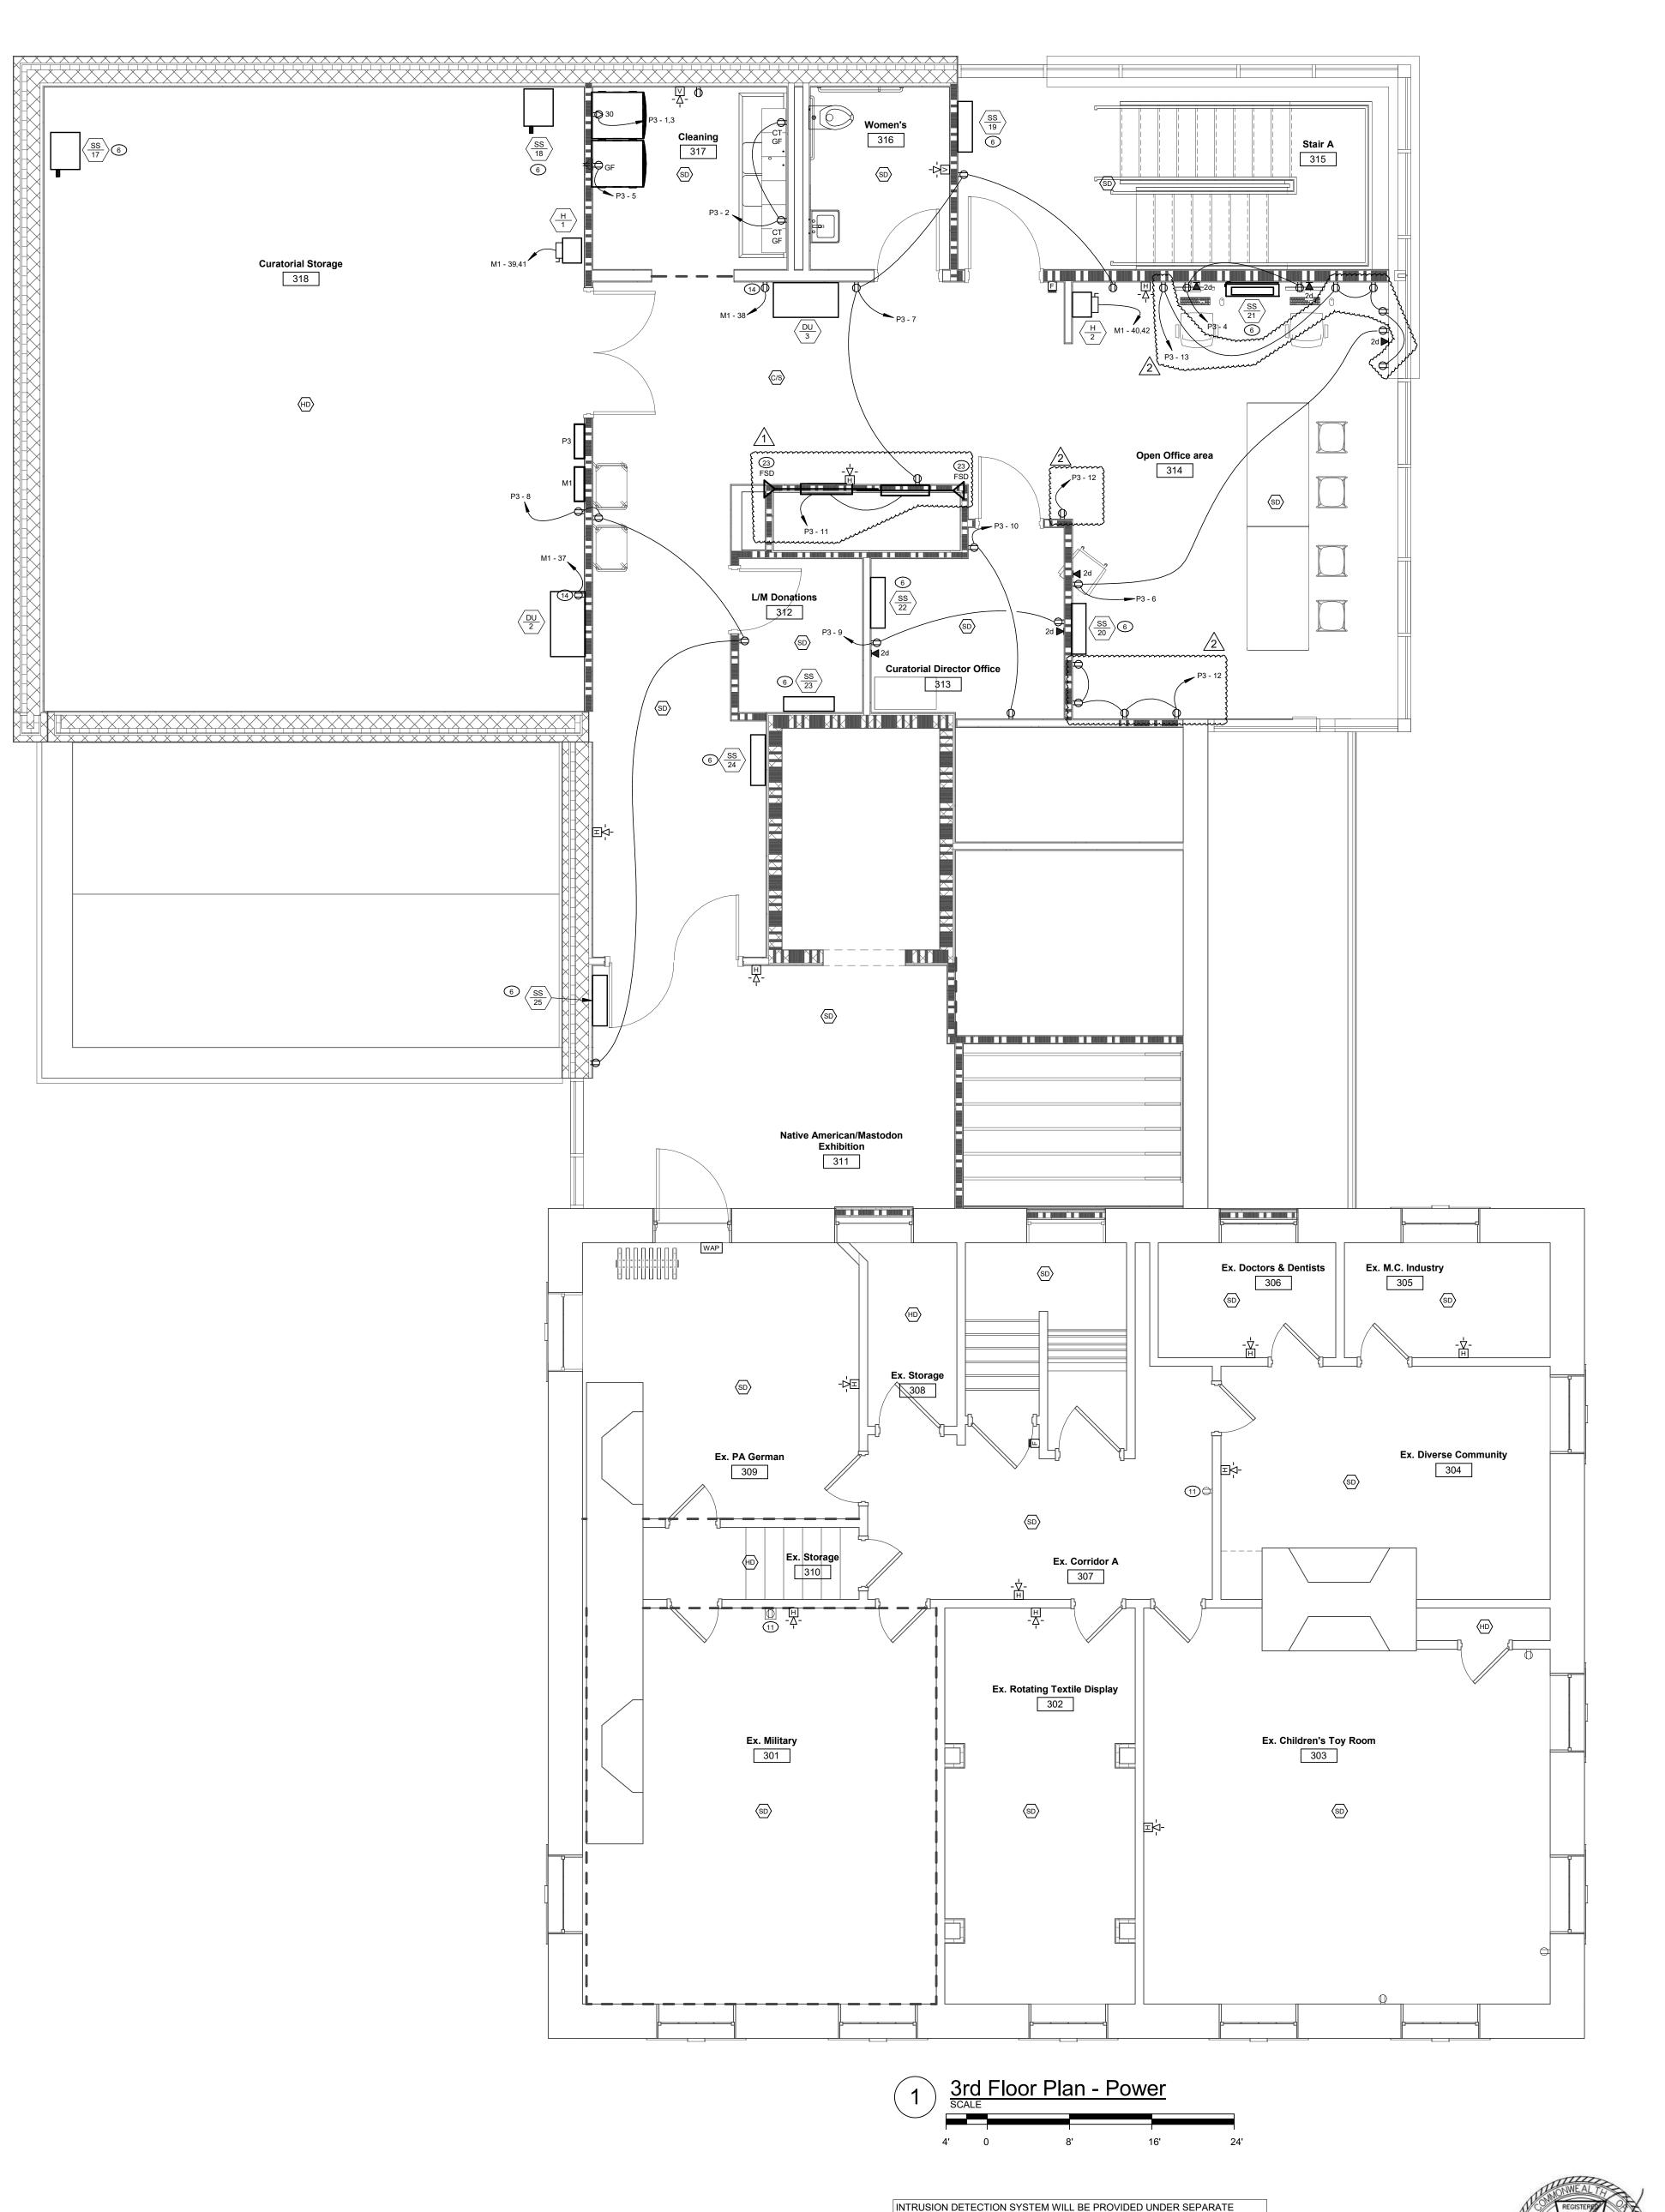

CONTRACT BY THE OWNER. OWNERS VENDOR WILL BE WORKING ON SITE AT SAME TIME AS CONTRACT. CONTRACTOR SHALL COORDINATE SITE AND

BUILDING ACCESS WITH VENDOR

**NEW WORK NOTES BY SYMBOL - ELECTRIC** 

WATER COOLER: PROVIDE DUPLEX GROUND FAULT RECEPTACLE FOR WATER COOLER. CONCEAL RECEPTACLE BELOW/BEHIND MOUNTING BOX OF COOLER.

2 REFER TO ELEVATOR PIT LIGHT DETAIL.

(3) REFER TO ELEVATOR POWER AND CONTROL WIRING DIAGRAM. 4 TELECOM DEMARC: PROVIDE 3/4"X6'X4'H PAINTED TREATED CDX PLYWOOD BACKBOARD FOR TELEPHONE AND COMMUNICATIONS

HEADEND EQUIPMENT PROVIDED BY UTILITY COMPANIES. (5) ELEVATOR PHONE LINES: PROVIDE CAT. 6 CABLES FROM ELEVATOR EQUIPMENT TO TELEPHONE DEMARC LOCATION. VERIFY EXACT QUANTITY AND TERMINATION LOCATION WITH ELEVATOR INSTALLER.

6 SPLIT SYSTEM: PROVIDE NEMA 3R DISCONNECT SWITCH FOR OUTDOOR UNIT. PROVIDE CONDUIT AND WIRING, AS PER PANEL SCHEDULE, FROM PANEL INDICATED TO OUTDOOR UNIT DISCONNECT SWITCH. PROVIDE FINAL ELECTRICAL CONNECTION TO OUTDOOR UNIT. PROVIDE POWER AND CONTROL CONDUIT AND WIRING, AS REQUIRED BY MANUFACTURER, FROM OUTDOOR UNIT TO INDOOR UNIT. INDOOR UNIT TO BE POWERED FROM OUTDOOR UNIT. PROVIDE FINAL ELECTRICAL CONNECTION TO INDOOR UNIT. COORDINATE ALL WORK WITH SPLIT SYSTEM INSTALLER. PROVIDE CIRCUIT BREAKER LOCKING DEVICE, FOR SPLIT SYSTEM CIRCUIT BREAKER, TO MEET THE REQUIREMENTS OF NEC 422.31.

7) FUTURE FLOOR BOX POWER: PROVIDE JUNCTION BOX FOR FUTURE POWER TO FUTURE FLOOR BOX. PROVIDE CONDUIT AND WIRING, AS INDICATED, FROM JUNCTION BOX TO PANEL INDICATED. CAP WIRES INJUNCTION BOX AND LABEL "FUTURE FLOOR BOX". PROVIDE CIRCUIT BREAKER LOCKING DEVICE TO LOCK BREAKER IN THE OFF POSITION.

(8) REFER TO TV OUTLET MOUNTING DETAIL.

9 DESTRAT FAN: PROVIDE SINGLE RECEPTACLE IN SURFACE CAST BOX MOUNTED ADJACENT TO DESTRAT FAN. COORDINATE EXACT LOCATION WITH FAN INSTALLER.

10) TRACK LIGHTING: PROVIDE SEPARATE LIGHTING FOR CONTROL OF TRACK LIGHTING. COORDINATE EXACT CONTROL LOCATION WITH OWNER PRIOR TO ROUGH-IN.

(11) EXISTING, SHOWN FOR COORDINATION.

12) EXISTING PANEL: PROVIDE NEW FEEDER CONDUIT AND CONDUCTORS, AS PER RISER DIAGRAM, FROM EXISTING PANEL BACK TO NEW MDP.

(13) KITCHEN HOOD: INSTALL ELECTRICAL DISCONNECT THAT COMES WITH HOOD. PROVIDE CONDUIT AND WIRING FROM DISCONNECT BACK TO PANEL INDICATED. PROVIDE ALL CONDUIT AND WIRING AND FINAL ELECTRICAL CONNECTION FROM DISCONNECT TO HOOD. PROVIDE ALL INTERCONNECTING CONDUIT AND WIRING BETWEEN HOOD AND FAN.

(14) DEHUMIDIFICATION UNIT: PROVIDE DUPLEX RECEPTACLE FOR USE WITH DEHUMIDIFICATION UNIT. COORDINATE EXACT LOCATION WITH UNIT INSTALLER.

(15) STRING LIGHTING: PROVIDE WP GF RECEPTACLE FOR USE WITH OWNER PROVIDED STRING LIGHTING. COORDINATE EXACT RECEPTACLE MOUNTING HEIGHT AND LOCATION WITH OWNER PRIOR TO ROUGH-IN.

(16) TAPE LIGHT: PROVIDE TIVOLI TPLE-SB-O-30-24 TAPE LIGHT IN MOFT-CHAN-SLV-6.5 MOUNTING CHANNEL WITH MOFT-LNS-OPL-6.5 LENS. CHANNEL SHALL BE RECESSED IN NEW SITE WALL. COORDINATE INSTALLATION WITH ARCHITECTURAL DRAWINGS. PROVIDE LENGTHS OF TAPELIGHT AND MOUNTING CHANNEL AS REQUIRED TO EXTEND AROUND ENTIRE WALL AS INDICATED. PROVIDE ADNM-320-3-4-24-D POWER SUPPLY FOR TAPELIGHT. PROVIDE ALL WIRING, AS PER MANUFACTURER, FROM TRANSFORMER TO SECTIONS OF TAPELIGHT AS REQUIRED TO NOT OVERLOAD POWER SUPPLY.

(17) REFER TO EXTERIOR LIGHTING CONTROL DIAGRAM.

(18) EXTERIOR WALL WASH: PROVIDE NEW LUMINAIRE AS INDICATED. CONNECT NEW LUMINAIRE TO EXISTING CONDUIT AND WIRING REMAINING FROM REMOVAL OF EXISTING LUMINAIRE. PROVIDE CONDUIT AND WIRING, FROM JUNCTION BOX, PROVIDED AS PE DEMOLITION NOTES BY SYMBOL, TO CIRCUIT INDICATED. WIRE THROUGH RELAY PANEL AS REQUIRED.

19) POST TOP LUMINAIRE: REFER TO CIVIL DRAWINGS FOR POST TOP LUMINAIRE SPECIFICATIONS AND POLE BASE INFORMATION. PROVIDE CONDUIT AND WIRING, AS INDICATED, FROM LUMINAIRE TO CIRCUIT INDICATED. PROVIDE DUAL-LITE LPS-55-S-RTSLP EMERGENCY LIGHTING INVERTER FOR POWERING LUMINAIRE DURING NORMAL POWER INTERRUPTION. PROVIDE ALL WIRING, AS PER MANUFACTURER, BETWEEN POWER SOURCE, EXTERIOR LIGHTING RELAY PANEL, INVERTER AND LUMINAIRE AS REQUIRED.


(20) ELEVATOR SUMP PUMP: PROVIDE DUPLEX RECEPTACLE FOR ELEVATOR SUMP PUMP. MOUNT RECEPTACLE ADJACENT TO SUMP PUMP CONTROL PANEL.

(21) EJECTOR PUMP: PROVIDE CONDUIT AND WIRING, AS INDICATED, FROM EJECTOR PUMP CONTROL PANEL TO CIRCUIT INDICATED. PROVIDE FINAL ELECTRICAL CONNECTION TO PUMP CONTROL

(22) SUMP PUMP: PROVIDE DUPLEX GF RECEPTACLE IN SURFACE

CAST BOX FOR SUMP PUMP. MOUNT RECEPTACLE IN SUMP PUMP BASIN. COORDINATE ALL WORK WITH SUMP PUMP INSTALLER. /1\ { (23) FIRE/SMOKE DAMPER: PROVIDE JUNCTION BOX FOR POWER CONNECTION TO FIRE/SMOKE DAMPER ACTUATOR. PROVIDE FIRE

ALARM ADDRESSABLE MODULE FOR SMOKE DAMPER. PROVIDE TOGGLE SWITCH FOR TESTING OF DAMPER. PROVIDE CONDUIT AND WIRING, AS PER PANEL SCHEDULE, FROM PANEL INDICATED THROUGH SWITCH, FIRE ALARM MODULE AND JUNCTION BOX TO SMOKE DAMPER ACTUATOR MOTOR. PROVIDE FINAL ELECTRICAL CONNECTIONS TO ALL ITEMS AS REQUIRED. COORDINATE ALL WORK WITH FIRE ALARM SYSTEM INSTALLER AND SMOKE DAMPER INSTALLER. MOUNT TOGGLE SWITCH AND ADDRESSABLE MODULE IN LOCATION DETERMINED BY OWNER. REFER TO FIRE/SMOKE DAMPER & DUCT DETECTOR DETAIL

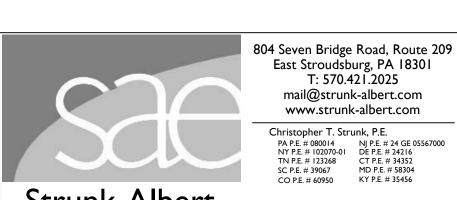

specified project. Reproduction or use without authorization is

Christopher T. Strunk, P.E. PA P.E. # 080014 NJ P.E. # 24 GE 05567000 NY P.E. # 102070-01 DE P.E. # 24216 TN P.E. # 123268 CT P.E. # 34352 SC P.E. # 39067 MD P.E. # 58304 CO P.E. # 60950 KY P.E. # 35456 Strunk-Albert

Engineered Systems and Building Consultants drawn designed checked drawing not valid without authorized sae signatures

This document is the sole propert and copyright of SAE for the SAE Project No: FHC-14619

T: 570.421.2025

mail@strunk-albert.com www.strunk-albert.com

architects

Silvia A. Hoffman, AIA, LEED Todd O. Chambers, AIA, Jill P. Hewes, AIA, LEED AP

Architecture Project Management

MKSD, LLC 1209 Hausman Road Suite A Allentown, PA 18104

866.512.MKSD toll free 610.366.2081 phone 610.366.8399 fax

SIGNATURE

**‡** socia Addi 8360 enter sburg, ge Str

Monroe ( Alteration REVISIONS 01.26.23 - Issued for Permit 02.07.23 Addendum 1

02.16.23 Addendum 2

900

DRAWING TITLE 3rd Floor Plan -Power


PROJECT NUMBER 16.200

DRAWN BY JRP SCALE As indicated

DATE 01.26.23

DRAWING NUMBER

c) MKSD, LLC www.mksdarchitects.com

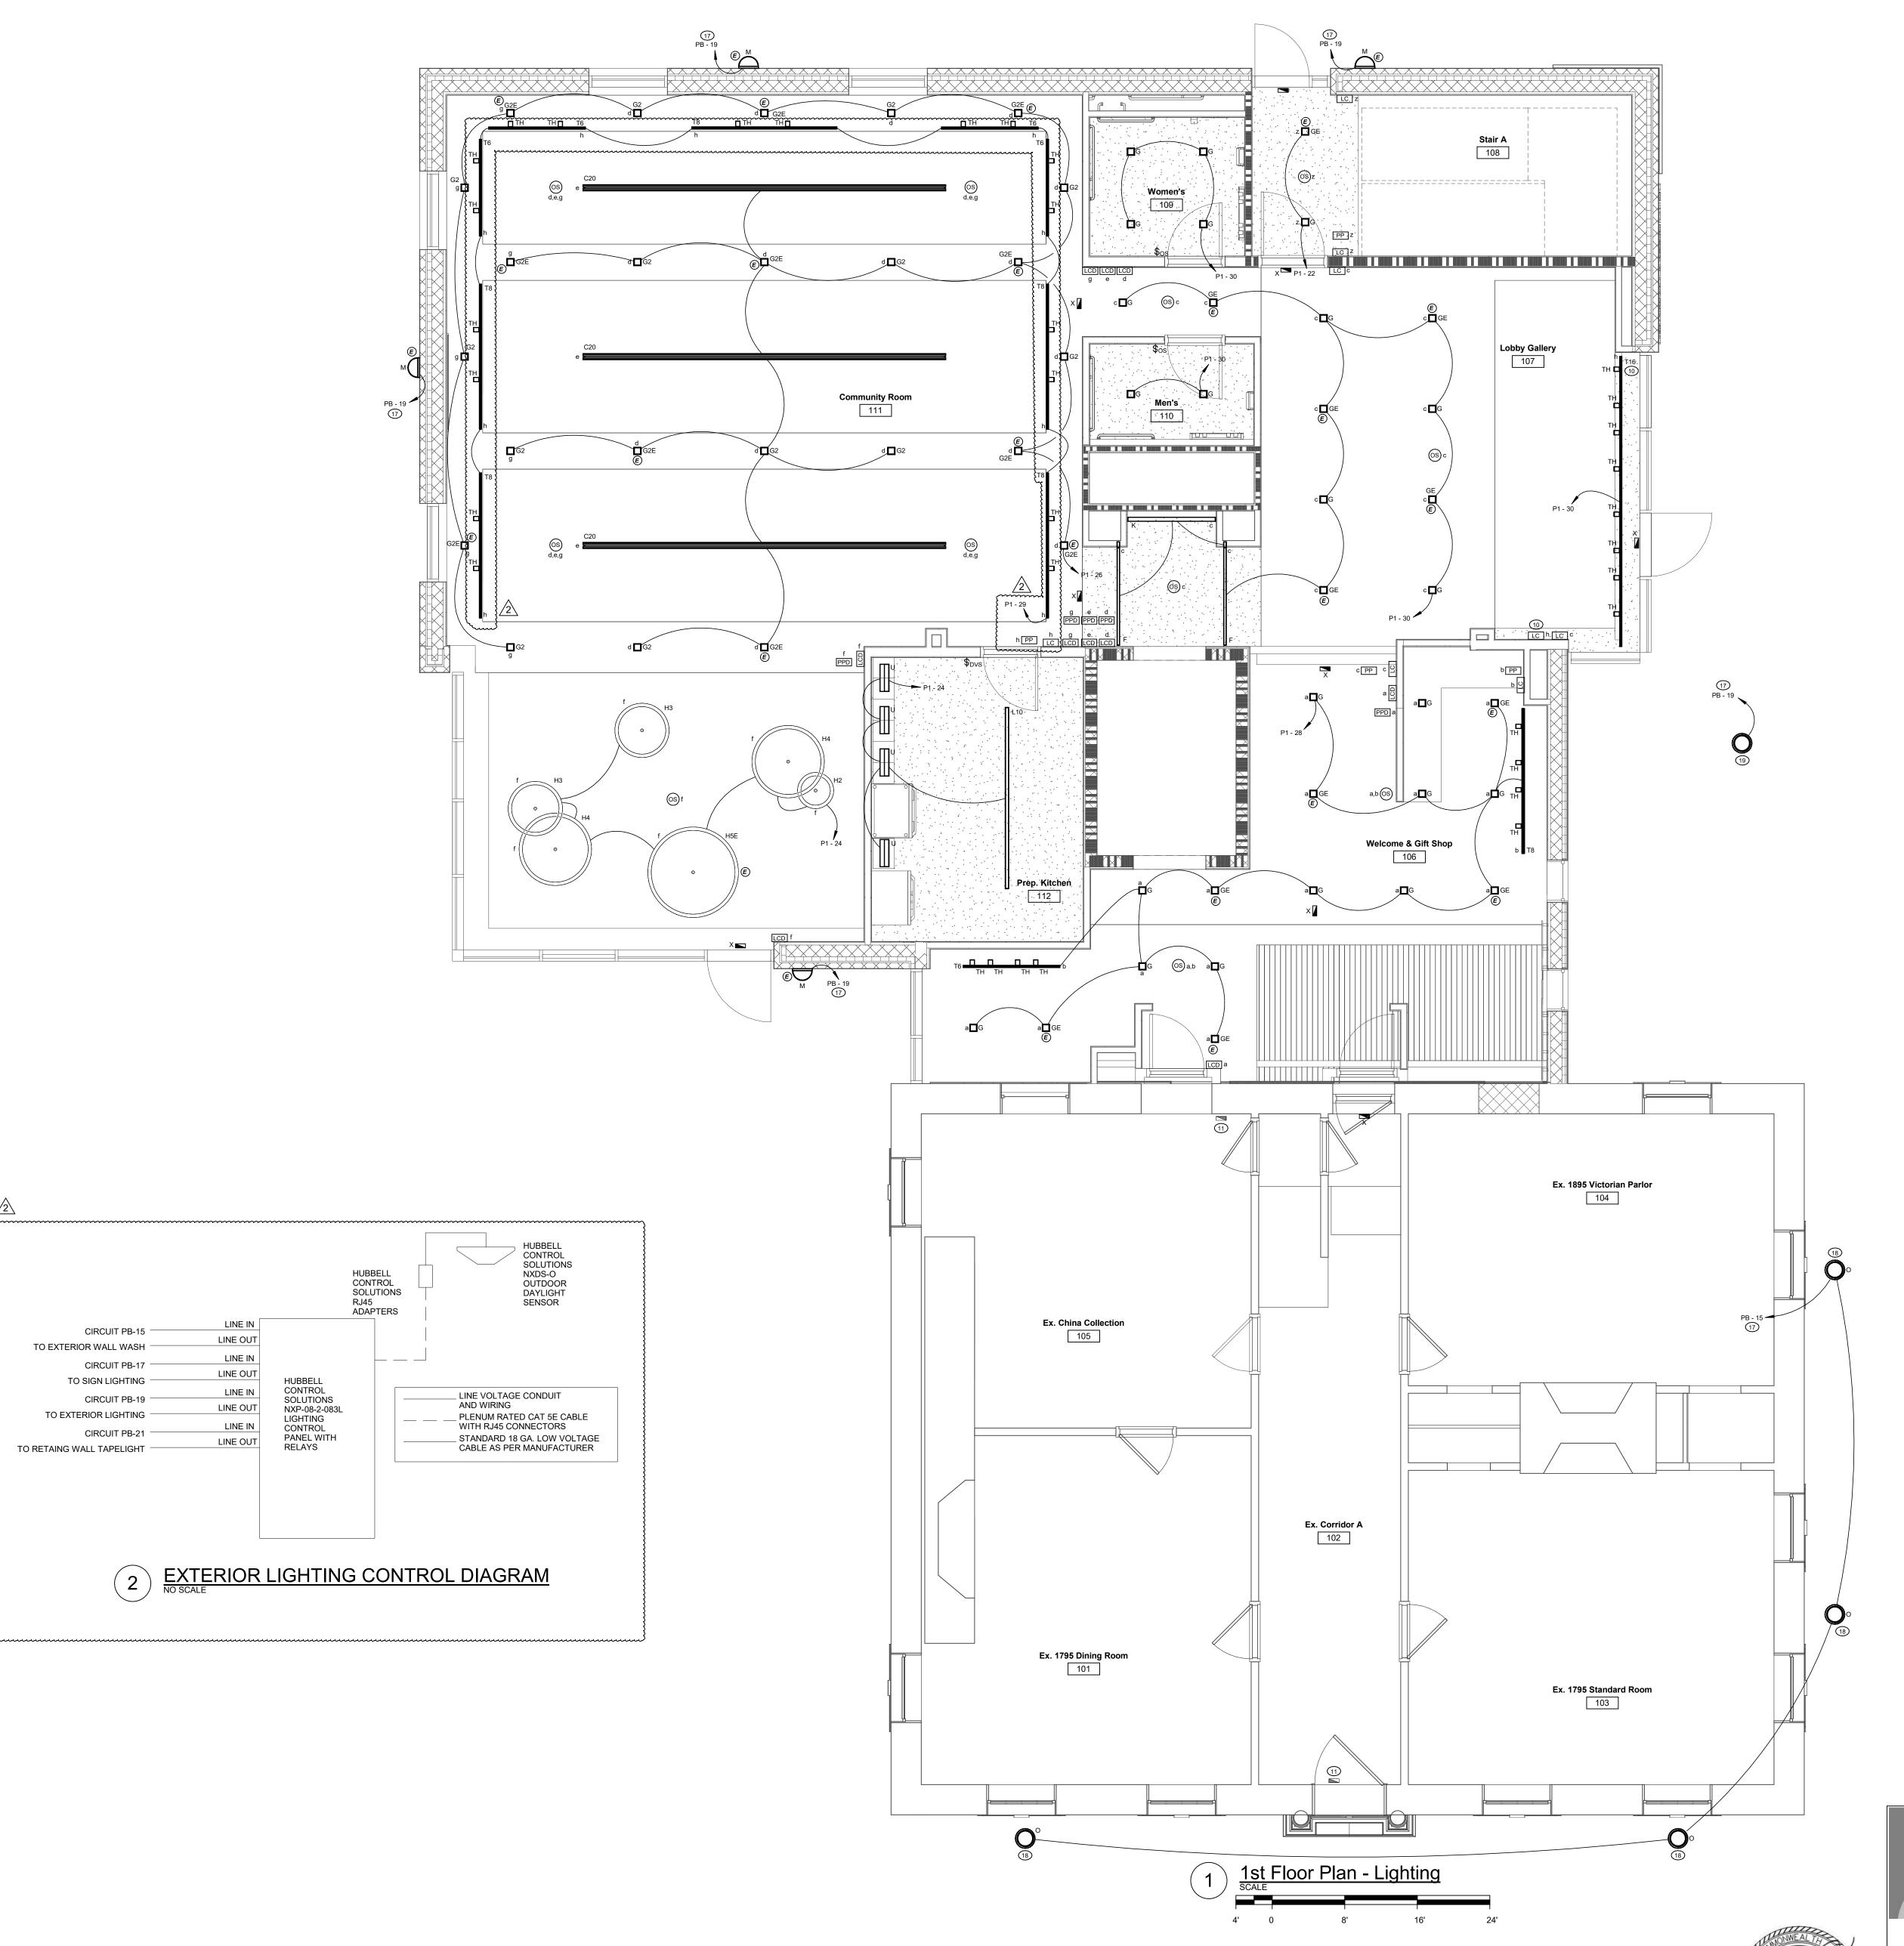

# NEW WORK NOTES BY SYMBOL - ELECTRIC

- WATER COOLER: PROVIDE DUPLEX GROUND FAULT RECEPTACLE FOR WATER COOLER. CONCEAL RECEPTACLE BELOW/BEHIND MOUNTING BOX OF COOLER.
- 2) REFER TO ELEVATOR PIT LIGHT DETAIL.
- 3 REFER TO ELEVATOR POWER AND CONTROL WIRING DIAGRAM.
  4 TELECOM DEMARC: PROVIDE 3/4"X6'X4'H PAINTED TREATED CDX
- PLYWOOD BACKBOARD FOR TELEPHONE AND COMMUNICATIONS
  HEADEND EQUIPMENT PROVIDED BY UTILITY COMPANIES.

  5 ELEVATOR PHONE LINES: PROVIDE CAT 6 CABLES FROM
- 5 ELEVATOR PHONE LINES: PROVIDE CAT. 6 CABLES FROM ELEVATOR EQUIPMENT TO TELEPHONE DEMARC LOCATION. VERIFY EXACT QUANTITY AND TERMINATION LOCATION WITH ELEVATOR INSTALLER.
- 6 SPLIT SYSTEM: PROVIDE NEMA 3R DISCONNECT SWITCH FOR OUTDOOR UNIT. PROVIDE CONDUIT AND WIRING, AS PER PANEL SCHEDULE, FROM PANEL INDICATED TO OUTDOOR UNIT DISCONNECT SWITCH. PROVIDE FINAL ELECTRICAL CONNECTION TO OUTDOOR UNIT. PROVIDE POWER AND CONTROL CONDUIT AND WIRING, AS REQUIRED BY MANUFACTURER, FROM OUTDOOR UNIT TO INDOOR UNIT. INDOOR UNIT TO BE POWERED FROM OUTDOOR UNIT. PROVIDE FINAL ELECTRICAL CONNECTION TO INDOOR UNIT. COORDINATE ALL WORK WITH SPLIT SYSTEM INSTALLER. PROVIDE CIRCUIT BREAKER LOCKING DEVICE, FOR SPLIT SYSTEM CIRCUIT BREAKER, TO MEET THE REQUIREMENTS OF NEC 422.31.
- 7 FUTURE FLOOR BOX POWER: PROVIDE JUNCTION BOX FOR FUTURE POWER TO FUTURE FLOOR BOX. PROVIDE CONDUIT AND WIRING, AS INDICATED, FROM JUNCTION BOX TO PANEL INDICATED. CAP WIRES INJUNCTION BOX AND LABEL "FUTURE FLOOR BOX". PROVIDE CIRCUIT BREAKER LOCKING DEVICE TO LOCK BREAKER IN THE OFF POSITION.
- 8 REFER TO TV OUTLET MOUNTING DETAIL.

BETWEEN HOOD AND FAN.

- 9 DESTRAT FAN: PROVIDE SINGLE RECEPTACLE IN SURFACE CAST BOX MOUNTED ADJACENT TO DESTRAT FAN. COORDINATE EXACT LOCATION WITH FAN INSTALLER.
- 10) TRACK LIGHTING: PROVIDE SEPARATE LIGHTING FOR CONTROL OF TRACK LIGHTING. COORDINATE EXACT CONTROL LOCATION WITH OWNER PRIOR TO ROUGH-IN.
- EXISTING, SHOWN FOR COORDINATION.
   EXISTING PANEL: PROVIDE NEW FEEDER CONDUIT AND CONDUCTORS, AS PER RISER DIAGRAM, FROM EXISTING PANEL
- BACK TO NEW MDP.

  (13) KITCHEN HOOD: INSTALL ELECTRICAL DISCONNECT THAT COMES WITH HOOD. PROVIDE CONDUIT AND WIRING FROM DISCONNECT BACK TO PANEL INDICATED. PROVIDE ALL CONDUIT AND WIRING AND FINAL ELECTRICAL CONNECTION FROM DISCONNECT TO HOOD. PROVIDE ALL INTERCONNECTING CONDUIT AND WIRING
- 14 DEHUMIDIFICATION UNIT: PROVIDE DUPLEX RECEPTACLE FOR USE WITH DEHUMIDIFICATION UNIT. COORDINATE EXACT LOCATION WITH UNIT INSTALLER.
- 15 STRING LIGHTING: PROVIDE WP GF RECEPTACLE FOR USE WITH OWNER PROVIDED STRING LIGHTING. COORDINATE EXACT RECEPTACLE MOUNTING HEIGHT AND LOCATION WITH OWNER PRIOR TO ROUGH-IN.
- TAPE LIGHT: PROVIDE TIVOLI TPLE-SB-O-30-24 TAPE LIGHT IN MOFT-CHAN-SLV-6.5 MOUNTING CHANNEL WITH MOFT-LNS-OPL-6.5 LENS. CHANNEL SHALL BE RECESSED IN NEW SITE WALL. COORDINATE INSTALLATION WITH ARCHITECTURAL DRAWINGS. PROVIDE LENGTHS OF TAPELIGHT AND MOUNTING CHANNEL AS REQUIRED TO EXTEND AROUND ENTIRE WALL AS INDICATED. PROVIDE ADNM-320-3-4-24-D POWER SUPPLY FOR TAPELIGHT. PROVIDE ALL WIRING, AS PER MANUFACTURER, FROM TRANSFORMER TO SECTIONS OF TAPELIGHT AS REQUIRED TO NOT OVERLOAD POWER SUPPLY.
- 17) REFER TO EXTERIOR LIGHTING CONTROL DIAGRAM.
- (18) EXTERIOR WALL WASH: PROVIDE NEW LUMINAIRE AS INDICATED. CONNECT NEW LUMINAIRE TO EXISTING CONDUIT AND WIRING REMAINING FROM REMOVAL OF EXISTING LUMINAIRE. PROVIDE CONDUIT AND WIRING, FROM JUNCTION BOX, PROVIDED AS PER DEMOLITION NOTES BY SYMBOL, TO CIRCUIT INDICATED. WIRE THROUGH RELAY PANEL AS REQUIRED.
- 19 POST TOP LUMINAIRE: REFER TO CIVIL DRAWINGS FOR POST TOP LUMINAIRE SPECIFICATIONS AND POLE BASE INFORMATION. PROVIDE CONDUIT AND WIRING, AS INDICATED, FROM LUMINAIRE TO CIRCUIT INDICATED. PROVIDE DUAL-LITE LPS-55-S-RTSLP EMERGENCY LIGHTING INVERTER FOR POWERING LUMINAIRE DURING NORMAL POWER INTERRUPTION. PROVIDE ALL WIRING, AS PER MANUFACTURER, BETWEEN POWER SOURCE, EXTERIOR LIGHTING RELAY PANEL, INVERTER AND LUMINAIRE AS REQUIRED.
- 20 ELEVATOR SUMP PUMP: PROVIDE DUPLEX RECEPTACLE FOR ELEVATOR SUMP PUMP. MOUNT RECEPTACLE ADJACENT TO SUMP PUMP CONTROL PANEL.
- EJECTOR PUMP: PROVIDE CONDUIT AND WIRING, AS INDICATED, FROM EJECTOR PUMP CONTROL PANEL TO CIRCUIT INDICATED. PROVIDE FINAL ELECTRICAL CONNECTION TO PUMP CONTROL
- 22 SUMP PUMP: PROVIDE DUPLEX GF RECEPTACLE IN SURFACE CAST BOX FOR SUMP PUMP. MOUNT RECEPTACLE IN SUMP PUMP BASIN. COORDINATE ALL WORK WITH SUMP PUMP INSTALLER.
- FIRE/SMOKE DAMPER: PROVIDE JUNCTION BOX FOR POWER CONNECTION TO FIRE/SMOKE DAMPER ACTUATOR. PROVIDE FIRE ALARM ADDRESSABLE MODULE FOR SMOKE DAMPER. PROVIDE TOGGLE SWITCH FOR TESTING OF DAMPER. PROVIDE CONDUIT AND WIRING, AS PER PANEL SCHEDULE, FROM PANEL INDICATED THROUGH SWITCH, FIRE ALARM MODULE AND JUNCTION BOX TO SMOKE DAMPER ACTUATOR MOTOR. PROVIDE FINAL ELECTRICAL CONNECTIONS TO ALL ITEMS AS REQUIRED. COORDINATE ALL WORK WITH FIRE ALARM SYSTEM INSTALLER AND SMOKE DAMPER INSTALLER. MOUNT TOGGLE SWITCH AND ADDRESSABLE MODULE IN LOCATION DETERMINED BY OWNER. REFER TO FIRE/SMOKE DAMPER & DUCT DETECTOR DETAIL



804 Seven Bridge Road, Route 209
East Stroudsburg, PA 18301
T: 570.421.2025
mail@strunk-albert.com
www.strunk-albert.com

Christopher T. Strunk, P.E.
PA P.E. # 080014
NY P.E. # 102070-01
TN P.E. # 123268
SC P.E. # 39067
CO P.E. # 60950
MD P.E. # 38456

Strunk-Albert
Engineering
Engineered Systems and Building Consultants

The substitute of the substitut

ingineered Systems and Building Consultants drawn designed chawing not valid without authorized sate of COPYRIGHT 2023

This document is the sole propert and copyright of SAE for the specified project. Reproduction or use without authorization is

SAE Project No: FHC-14619

MK SD

architects

Silvia A. Hoffman, AIA, LEED AP Todd O. Chambers, AIA, NCARB Jill P. Hewes, AIA, LEED AP

Architecture Interiors Project Management

MKSD, LLC 1209 Hausman Road Suite A Allentown, PA 18104

866.512.MKSD toll free 610.366.2081 phone 610.366.8399 fax

SIGNATURE

orical Association Center Addition dsburg, PA 18360

on & Heritage Center Main Street - Stroudsburg, PA 1

Alte

900

No. Date Description
2 02.16.23 Addendum 2

DRAWING TITLE

1st Floor Plan Lighting

PROJECT NUMBER 16.200

JRP
SCALE
As indicated

01.26.23

DRAWING NUMBER

DATE

**E20**<sup>5</sup> © MKSD, LLC

www.mksdarchitects.com

	Location: Mechanical 008 Supply From: Mounting: Enclosure:		Volts: 120/208 Phases: 3 Wires: 4	Wye	A.I.C. Ratii Mains Ty Mains Ratii MCB Ratii	oe: MCB ng: 600 A	
Notes:							
0.47							
<b>CKT</b> 1	PB Circuit Descr	iption	# of Poles	Trip Rating 100 A	<b>Load</b> 14802 VA	Remarks	
2	P1		3	100 A	26308 VA		
3	P2		3	100 A	8877 VA		
4	P3		3	100 A	12586 VA		
5	M1		3	400 A	81593 VA		
6	Elevator		3	50 A	12240 VA		
7	A		2	100 A	11000 VA		
8	В		2	100 A	11000 VA		
9	С		2	100 A	11000 VA		
10	TVSS		3	60 A	0 VA		
	•		1		189405 VA		
					525.7 A		
Load Class	ification	Connected Load	Demand Factor	Estimated Demand		Panel '	Totals
Equipment		8226 VA	100.00%	8226 VA			
Existing Loa	ad	33000 VA	125.00%	41250 VA		Conn. Load:	
HVAC		80849 VA	125.00%	101061 VA		st. Demand:	
KITCHEN		8000 VA	100.00%	8000 VA		nn. Current:	
_ighting		12239 VA	125.00%	15298 VA	Total Est. Dema	nd Current:	583.3 A
Motor		15513 VA	100.00%	15513 VA			
Receptacle		31579 VA	65.83%	20790 VA			

TYPE	MANUFACTURER: MODEL	LOAD	I AMD TVDE	MOUNTING	DESCRIPTION	LUMENS	NOTES
ITPE	MANUFACTURER. MODEL	LOAD	LAWP I TPE	MOUNTING	DESCRIPTION	LUIVIENS	NOTES
3	COLUMBIA: CFP22-40/33/2835-CFPSMK-22	40 VA		CEILING/SURFACE	2X2 SURFACE MOUNT	4281 lm	
C20	FINELITE: HO4-ID-RO-20'-H-H-835-F-OPN-120-FA-OE-SC-C4	268 VA	LED	CEILING/SUSPENDED	20' LINEAR SUSPENDED	21660 lm	VERIFY MOUNTING HEIGHT WITH ARCHITECT
D ELEV	COLUMBIA: RLW4-35ML-FAW-ED-U ATLAS: ILW25LED2	40 VA 24 VA	LED LED	CEILING/SURFACE WALL/SURFACE	LINEAR WRAP SURFACE MOUNT LED	5222 lm 3092 lm	VERIFY EXACT MOUNTING LOCATION WITH ELEVATOR INSTALLER
F	PINNACLE: EV1-A-835-WC7'2"X5'5"-SF(S)-U-OL2-1-W	54 VA	LED	CEILING/WALL/RECESSED	LINEAR RECESSED WALL TO CEILING LED	125 lm	LUMINAIRE SHALL BE CONTINUOUS UP WALL AND ACROSS CEILING
=V	VERTICLE PORTION OF LUMINAIRE TYPE F	1 VA	LED			125 lm	
3	ALPHABET: NU4QD-XTM19-30LM-35K-83-HE60-UNV-DIM10-NC-WH-WH	26 VA	LED	CEILING/RECESSED/GYP	SQUARE LED DOWNLIGHT	1720 lm	
<b>3</b> 2	ALPHABET: NU3QD-XTM19-27LM-35K-83-HE60-277-DIM10-NC-WH-WH	29 VA	LED	CEILING/RECESSED/GYP	SQUARE LED DOWNLIGHT	2350 lm	
G2E	ALPHABET: NU3QD-XTM19-27LM-35K-83-HE60-277-DIM10-NC-WH-WH-EM12	29 VA	LED	CEILING/RECESSED/GYP	SQUARE LED DOWNLIGHT	2350 lm	PROVIDE WITH EMERGENCY BATTERY PACK
33	ALPHABET: NU4RD-XTM19-40LM-35K-83-HE60-277-DIM10-NC-WH-WH	49 VA	LED	CEILING/RECESSED/GYP	SQUARE LED DOWNLIGHT	3430 lm	
G3E	ALPHABET: NU4RD-XTM19-40LM-35K-83-HE60-277-DIM10-NC-WH-WH-EM12	49 VA	LED	CEILING/RECESSED/GYP	SQUARE LED DOWNLIGHT	3430 lm	PROVIDE WITH EMERGENCY BATTERY PACK
G4	ALPHABET: NU4QD-XTM19-30LM-35K-83-HE60-UNV-DIM10-NC-WH-WH	26 VA	LED	CEILING/RECESSED/GYP	SQUARE LED DOWNLIGHT	1720 lm	PROVIDE WITH TENMAT FF109-250 1-HOUR FIRE RATED DOWNLIGHT COVER AND INSTALL PER MANUFACTURERS RECOMMENDATIONS
G4E	ALPHABET: NU4QD-XTM19-30LM-35K-83-HE60-UNV-DIM10-NC-WH-WH-EM12	26 VA	LED	CEILING/RECESSED/GYP	SQUARE LED DOWNLIGHT	1720 lm	PROVIDE WITH TENMAT FF109-250 1-HOUR FIRE RATED DOWNLIGHT COVER AND INSTALL PER MANUFACTURERS RECOMMENDATIONS; PROVIDE EMERGENCY BATTERY PACK
GE	ALPHABET: NU4QD-XTM19-30LM-35K-83-HE60-UNV-DIM10-NC-WH-WH-EM12	26 VA	LED	CEILING/RECESSED/GYP	SQUARE LED DOWNLIGHT	1720 lm	PROVIDE WITH EMERGENCY BATTERY PACK
H2	BETA CALCO: 953105-D35-N35-S1-D1-XX	43 VA	LED	CEILING/SUSPENDED	RING PENDANT	4482 lm	VERIFY MOUNTING HEIGHT AND FINISH WITH ARCHITECT
H3	BETA CALCO: 953110-D35-N35-S1-D1-XX	64 VA	LED	CEILING/SUSPENDED	RING PENDANT	6719 lm	VERIFY MOUNTING HEIGHT AND FINISH WITH ARCHITECT
Н3Е	BETA CALCO: 953110-D35-N35-S1-D1-XX-RE	64 VA	LED	CEILING/SUSPENDED	RING PENDANT	6719 lm	VERIFY MOUNTING HEIGHT AND FINISH WITH ARCHITECT; PROVIDE WITH EMERGENCY BATTERY PACK
H4	BETA CALCO: 953120-D35-N35-S1-D1-XX	80 VA	LED	CEILING/SUSPENDED	RING PENDANT	9064 lm	VERIFY MOUNTING HEIGHT AND FINISH WITH ARCHITECT
H5E	BETA CALCO: 953130-D35-N35-S1-D1-XX-RE	108 VA	LED	CEILING/SUSPENDED	RING PENDANT	11350 lm	VERIFY MOUNTING HEIGHT AND FINISH WITH ARCHITECT; PROVIDE WITH EMERGENCY BATTERY PACK
J JE	COLUMBIA: LCL4-35ML-EU COLUMBIA: LCL4-35ML-EU-ELL14	42 VA 42 VA	LED LED	CEILING/SURFACE CEILING/SURFACE	LED STRIP LIGHT LED STRIP LIGHT	5329 lm 5329 lm	PROVIDE WITH EMERGENCY BATTERY PACK
<	FOCAL POINT: FSM2PR-ALH-FLO-250LF-35K-1C-UNV-LD1-TF-WH-5'	16 VA	LED	CEILING/RECESSED/GYP	RECESSED PERIMETER LED	1250 lm	
.4	FINELITE: HP2R-4'-V-835-F-96LG-120-SC-FC10-SF-FE-SW	37 VA	LED	CEILING/RECESSED	LINEAR RECESSED LED	3288 lm	
6	FINELITE: HP2R-6'-V-835-F-96LG-120-SC-FC10-SF-FE-SW	55 VA	LED	CEILING/RECESSED	LINEAR RECESSED LED	4932 lm	
.10	FINELITE: HP2R-10'-V-835-F-96LG-120-SC-FC10-SF-FE-SW	92 VA	LED ARRAY	CEILING/RECESSED	LINEAR RECESSED LED	8220 lm	
.14	FINELITE: HP2R-14'-V-835-F-96LG-120-SC-FC10-SF-FE-SW	129 VA	LED	CEILING/RECESSED	LINEAR RECESSED LED	11508 lm	VERIFY CEILING TYPE WITH ARCHITECT
.14E	FINELITE: HP2R-14'-V-835-F-96LG-120-SC-FC10-SF-FE-SW-FAC CHO	129 VA	LED	CEILING/RECESSED	LINEAR RECESSED LED	11508 lm	VERIFY CEILING TYPE WITH ARCHITECT; PROVIDE WITH EMERGENCY BATTERY PACK
Л	BEACON:TRP2-24L-30-4K7-3-UNV-20F-EH	30 VA	LED	WALL/SURFACE	EXTERIOR WALL PACK	3747 lm	VERIFY MOUNTING HEIGHT WITH ARCHITECT
١	LUMENPULSE: LOG-120-36-DWH-WWLF-WAM12-ETE	50 VA	LED	WALL/SURFACE	WALL MOUNTED SIGN LIGHT	2583 lm	VERIFY MOUNTING HEIGHT AND FINISH WITH ARCHITECT
)	KIM: LTV81-HS-WW-36L-3K-UV	44 VA	LED	IN GRADE	IN GROUND WALL WASH	3489 lm	MOUNT WHERE EXISTING WALL WASH WAS REMOVED
T6	BRUCK: 370GES-6'-XX/370GES-41-XX/370GES-11-XX			WALL/CEILING/SURFACE	SURFACE MOUNTED TRACK		PROVIDE ALL REQUIRED MOUNTIN COMPONENTS AND CONNECTORS FOR LENGTH OF TRACK REQUIRED
Γ8	BRUCK: 370GES-8'-XX/370GES-41-XX/370GES-11-XX			WALL/CEILING/SURFACE	SURFACE MOUNTED TRACK		PROVIDE ALL REQUIRED MOUNTIN COMPONENTS AND CONNECTORS FOR LENGTH OF TRACK REQUIRED
Γ16	BRUCK: 370GES-16'-XX/370GES-41-XX/370GES-11-XX			WALL/CEILING/SURFACE	SURFACE MOUNTED TRACK		PROVIDE ALL REQUIRED MOUNTING COMPONENTS AND CONNECTORS FOR LENGTH OF TRACK REQUIRED
ГН	BRUCK: 350431-22LM-35K-90-36-120-ELV-XX-ECOXX	20 VA	LED	TRACK	TRACK HEAD	2200 lm	FINISH SELECTED BY ARCHITECT
J	SIMKAR: EVLED-18	12 VA	LED	UNDERCABINET/SURFACE	UNDERCABINET LED	800 lm	PROVIDE LINKING CORDS AS REQUIRED
X	DUAL-LITE: SE-x-R-W-E-I	4 VA	LED	WALL/CEILING/SURFACE	SELF POWERED EXIT SIGN		PROVIDE SINGLE OR DOUBLE FAC

# LUMINAIRE SCHEDULE NOTES

- 1. CONTRACTOR SHALL VERIFY VOLTAGE AT SITE. VOLTAGE OF NORMAL AND EMERGENCY LUMINAIRES MAY VARY.
- PROVIDE SINGLE OR DOUBLE FACE EXITS WHERE SHOWN ON DRAWING.
- DIMENSIONS FOR CONTINUOUS LINEAR LUMINAIRES MUST BE FIELD MEASURED. LUMINAIRES DESIGNATED AS HAVING INTERNAL/REMOTE EMERGENCY BATTERY PACK/BALLAST SHALL BE CAPABLE OF PRODUCING A MINIMUM ILLUMINATION OF 1100 LUMENS IN THE EMERGENCY MODE.
- ALL FINISHES SHALL BE SELECTED BY THE ARCHITECT FROM MANUFACTURER'S FULL RANGE OF STANDARD FINISHES. PROVIDE SLOPED CEILING ADAPTER IF/AS REQUIRED.
- WHERE INDICATED, INTERNAL/REMOTE EMERGENCY BATTERY PACK/BALLAST CAPABLE OF PRODUCING A MINIMUM OUTPUT OF 1000 LUMENS IN THE EMERGENCY MODE. PROVIDE HANGER BARS AS REQUIRED.
- DIMENSIONS FOR ALL CONTINUOUS LINEAR LUMINAIRES MUST BE FIELD MEASURED. 10. PROVIDE POWER CORD ATTACHED TO AIRCRAFT CABLE OR CHAIN, WHITE OR BLACK AS SPECIFIED BY ARCHITECT/ENGINEER. PROVIDE CLEAR TIE WRAP TO SECURE POWER CABLE TO CABLE OR CHAIN.

	Branch P	anel: M1													
		Location: Curatorial Storage pply From: MDP Mounting: Surface Enclosure: Type 1	318				Volts: Phases: Wires:		Wye				A.I.C. Rating: 22,000 Mains Type: MLO Mains Rating: 400 A MCB Rating: 0 A		
скт	Circuit Description	Conduit & Wire	Trip	Poles		A		В		C	Poles	Trip	Conduit & Wire	Circuit Description	СКТ
1	Split System	3/4"C, 2#8, #8N, #10G	35 A	2		915 VA					2	15 A	3/4"C, 2#12, #12N, #12G	Split System	2
3							1997 VA	915 VA							4
5	Split System	3/4"C, 2#10, #10N, #10G	25 A	2					1839 VA	1997 VA	2	35 A	3/4"C, 2#8, #8N, #10G	Split System	6
7					1839 VA	1997 VA									8
9	Split System	3/4"C, 2#8, #8N, #10G	35 A	2			1997 VA	915 VA			2	15 A	3/4"C, 2#12, #12N, #12G	Split System	10
11									1997 VA	915 VA			-		12
13	Split System	3/4"C, 2#8, #8N, #10G	35 A	2	1997 VA	2912 VA					2	50 A	3/4"C, 2#6, #6N, #10G	Split System	14
15							1997 VA	2912 VA							16
17	Split System	3/4"C, 2#8, #8N, #10G	35 A	2						1581 VA	2	25 A	3/4"C, 2#10, #10N, #10G	Split System	18
19					1997 VA	1581 VA									20
21	Split System	3/4"C, 2#8, #8N, #10G	35 A	2			915 VA	2912 VA			2	50 A	3/4"C, 2#6, #6N, #10G	Split System	22
23	<u>'</u>									2912 VA					24
25	Split System	3/4"C, 2#10, #10N, #10G	25 A	2	2080 VA	2080 VA					2	30 A	3/4"C, 2#10, #10N, #10G	Split System	26
27							2080 VA	2080 VA							28
29	Split System	3/4"C, 2#8, #8N, #10G	40 A	2						2080 VA	2	30 A	3/4"C, 2#10, #10N, #10G	Split System	30
31					2272 VA	2080 VA									32
33	Split System	3/4"C, 2#12, #12N, #12G	20 A	2			1431 VA	1581 VA			2	25 A	3/4"C, 2#10, #10N, #10G	Split System	34
35									1431 VA	1581 VA					36
37	Dehumidification Unit	3/4"C, 1#12, #12N, #12G	20 A	1	960 VA	960 VA					1	20 A	3/4"C, 1#12, #12N, #12G	Dehumidification Unit	38
39	Humidifier	3/4"C, 2#12, #12N, #12G	20 A	2			2 VA	2 VA			2	20 A	3/4"C, 2#12, #12N, #12G	Humidifier	40
41									2 VA	2 VA					42
43															44
45															46
47															48
49						4224 VA					3	60 A	1-1/4"C, 3#4, #4N, #10G	Rooftop Unit	50
51								4224 VA							52
53										4224 VA					54
			To	tal Load:	2988	89 VA	2596	0 VA	2574	14 VA					
				tal Amps:		0.4 A		5.6 A		.5 A	]				
l nad C	lassification			nnected L			mand Fac			nated Dei	mand		Pano	I Totals	
HVAC	idosilication			79673 V		De	125.00%			99591 VA			i dile	i i otais	
	a a la												Total Cana I and	. 01503 \/A	
Recepta	ACIE			1920 VA		-	100.00%			1920 VA			Total Conn. Load		
													Total Est. Demand		
													Total Conn. Current		
													Total Est. Demand Current	: 281.8 A	
														+	

	Branch Pa	anel: PB																
		Location: Mechanical 008					Volts:	120/208 \	Nye			<b>A.I.C. Rating:</b> 22,000						
	Sup	ply From: MDP					Phases:	3					Mains Type: MLO					
	i	Mounting: Surface					Wires:	4					Mains Rating: 100 A					
		inclosure: Type 1											MCB Rating: 0 A					
СКТ	Circuit Description	Conduit & Wire	Trip	Poles		A		3		c	Poles	Trip	Conduit & Wire	Circuit Description	СКТ			
1	Receptacle	3/4"C, 1#12, #12N, #12G	20 A	1	180 VA	180 VA					1	20 A	3/4"C, 1#12, #12N, #12G	Receptacle	2			
3	Elevator Cab Lighting	3/4"C, 1#12, #12N, #12G	20 A	1			100 VA	900 VA			1	20 A	3/4"C, 1#12, #12N, #12G	Receptacle	4			
5	Receptacle, Water Cooler	3/4"C, 1#12, #12N, #12G	20 A	1					1765 VA	360 VA	1	20 A	3/4"C, 1#12, #12N, #12G	Telecom Equipment	6			
7	Data Rack	3/4"C, 1#12, #12N, #12G	20 A	1	500 VA	360 VA					1	20 A	3/4"C, 1#12, #12N, #12G	Telecom Equipment	8			
9	Data Rack	3/4"C, 1#12, #12N, #12G	20 A	1			500 VA	1176 VA			1	20 A	3/4"C, 1#12, #12N, #12G	Circulator Pump	10			
11	Dehumidification Unit	3/4"C, 1#12, #12N, #12G	20 A	1					960 VA	960 VA	1	20 A	3/4"C, 1#12, #12N, #12G	Dehumidification Unit	12			
13	Cabinet Heater	3/4"C, 1#12, #12N, #12G	20 A	1	500 VA	500 VA					1	20 A	3/4"C, 1#12, #12N, #12G	Elevator Sump Pump	14			
15	Lighting	3/4"C, 1#12, #12N, #12G	20 A	1			176 VA	1176 VA			1	20 A	3/4"C, 1#12, #12N, #12G	Ejector Pump	16			
17	Lighting	3/4"C, 1#12, #12N, #12G	20 A	1					100 VA	864 VA	1	20 A	3/4"C, 1#12, #12N, #12G	Sump Pump	18			
19	Lighting	3/4"C, 1#12, #12N, #12G	20 A	1	224 VA	600 VA					1	20 A	3/4"C, 1#12, #12N, #12G	Fire/Smoke Dampers	20			
21	Exterior Tapelight	3/4"C, 1#12, #12N, #12G	20 A	1			240 VA				······				22			
23	Lighting	3/4"C, 1#12, #12N, #12G	20 A	1					626 VA						24			
25	Lighting	3/4"C, 1#12, #12N, #12G	20 A	1	882 VA	133 VA					1	20 A	3/4"C, 1#12, #12N, #12G	Exhaust Fan	26			
27	Lighting	3/4"C, 1#12, #12N, #12G	20 A	1			42 VA	250 VA			1	20 A	3/4"C, 1#12, #12N, #12G	Unit Heater	28			
29	Lighting	3/4"C, 1#12, #12N, #12G	20 A	1					48 VA	500 VA	1	20 A	3/4"C, 1#12, #12N, #12G	Fire Alarm Control Panel	30			
			То	tal Load:	405	9 VA	4560	AV C	6183 VA									
			Tot	al Amps:	33.	8 A	38.	6 A	52.	2 A								
oad CI	assification		Cor	nected L	oad	De	mand Fac	tor	Estir	nated Den	nand		Pane	el Totals				
quipme	ent			2376 VA			100.00%			2376 VA								
ighting				2338 VA			125.00%			2923 VA			Total Conn. Load	l: 14802 VA				
lotor				2059 VA			100.00%			2059 VA			Total Est. Demand	l: 15387 VA				
ecepta	cle			8029 VA			100.00%			8029 VA			Total Conn. Current	: 41.1 A				
													Total Est. Demand Current	: 42.7 A				

Square 'D' type "NQ" Panels 'Q\_B' B olt-On Breakers


Square 'D' type "NQ" Panels 'Q\_B' B olt-On Breakers


Ground Bar Kit


Ground Bar Kit

		pply From: MDP Mounting: Surface Enclosure: Type 1					Phases: Wires:	-					Mains Type: MLO Mains Rating: 100 A MCB Rating: 0 A		
СКТ	Circuit Description	Conduit & Wire	Trip	Poles		<b>A</b>	E	3		С	Poles	Trip	Conduit & Wire	Circuit Description	СКТ
1	Water Cooler	3/4"C, 1#12, #12N, #12G	20 A	1	325 VA	360 VA					1	20 A	3/4"C, 1#12, #12N, #12G	Receptacle	2
3	Receptacle	3/4"C, 1#12, #12N, #12G	20 A	1			720 VA	720 VA			1	20 A	3/4"C, 1#12, #12N, #12G	Receptacle	4
	Receptacle	3/4"C, 1#12, #12N, #12G	20 A	1					360 VA	900 VA	1	20 A	3/4"C, 1#12, #12N, #12G	Receptacle	6
	Receptacle	3/4"C, 1#12, #12N, #12G	20 A	1	360 VA	720 VA					1	20 A	3/4"C, 1#12, #12N, #12G	Receptacle	8
	Receptacle	3/4"C, 1#12, #12N, #12G	20 A	1			720 VA	360 VA			1		3/4"C, 1#12, #12N, #12G	Receptacle	10
	Receptacle	3/4"C, 1#12, #12N, #12G	20 A	1					360 VA	300 VA	1	20 A	3/4"C, 1#12, #12N, #12G	Fire/Smoke Dampers	12
13															14
15															16
17															18
19															20
21										1236 VA	1	20.4	2/4"C 1#12 #12N #12C	Lighting	22
25						364 VA				1230 VA	1		3/4"C, 1#12, #12N, #12G 3/4"C, 1#12, #12N, #12G	Lighting	26
27						304 VA					!	20 A	3/4 C, 1#12, #12N, #12G	Lighting	28
	Destrat Fans	3/4"C, 1#12, #12N, #12G	20 A	1					240 \/Δ	832 VA	1	20 Δ	3/4"C, 1#12, #12N, #12G	Lighting	30
	Destruct ans	014 0, 1#12, #1214, #120		tal Load:	2129	 Ο \/Δ	2520	 ) \/Δ		8 VA	'	207	0/4 0, 1#12, #1214, #120	Ligiting	- 30
				al Amps:	17.		21.			.7 A					
and Cla	ssification		1	nected L			mand Fac			mated Der	nand		Panel	Totals	
			COI	300 VA	.oau			ior	ESUI		IIariu		Pallel	IOLAIS	
Equipmen	IL .						100.00%			300 VA			Total Comm. Londs	0077.1/4	
ighting				2432 VA			125.00%			3040 VA			Total Conn. Load:		
<b>Motor</b>				240 VA			100.00%			240 VA			Total Est. Demand:		
Receptacl	le			5905 VA			100.00%			5905 VA			Total Conn. Current:		
													Total Est. Demand Current:	26.3 A	

	Su				Volts: Phases: Wires:		<b>Wye</b>		A.I.C. Rating: 10,000  Mains Type: MLO  Mains Rating: 100 A  MCB Rating: 0 A						
СК	T Circuit Description	Conduit & Wire	Trip	Poles		4	E	3	(	<b>;</b>	Poles	Trip	Conduit & Wire	Circuit Description	СКТ
1	Refrigerator	3/4"C, 1#12, #12N, #12G	20 A	1	1000 VA	900 VA					1	20 A	3/4"C, 1#12, #12N, #12G	Exterior Receptacle	2
3	Receptacle	3/4"C, 1#12, #12N, #12G	20 A	1			180 VA	325 VA			1	20 A	3/4"C, 1#12, #12N, #12G	Water Cooler	4
5	Receptacle	3/4"C, 1#12, #12N, #12G	20 A	1					360 VA	540 VA	1	20 A	3/4"C, 1#12, #12N, #12G	Receptacle	6
7	Range	3/4"C, 2#6, #6N, #10G	50 A	2	4000 VA	540 VA					1	20 A	3/4"C, 1#12, #12N, #12G	Receptacle	8
9							4000 VA	720 VA			1	20 A	3/4"C, 1#12, #12N, #12G	Receptacle	10
11	Receptacle	3/4"C, 1#12, #12N, #12G	20 A	1					540 VA	900 VA	1	20 A	3/4"C, 1#12, #12N, #12G	Receptacle	12
13	Receptacle	3/4"C, 1#12, #12N, #12G	20 A	1	720 VA	360 VA					1	20 A	3/4"C, 1#12, #12N, #12G	Receptacle	14
15	Receptacle	3/4"C, 1#12, #12N, #12G	20 A	1			900 VA	1080 VA			1	20 A	3/4"C, 1#12, #12N, #12G	Receptacle	16
17	Future Floor Box	3/4"C, 1#12, #12N, #12G	20 A	1					180 VA	1900 VA	1	20 A	3/4"C, 1#12, #12N, #12G	Motor	18
19	Future Floor Box	3/4"C, 1#12, #12N, #12G	20 A	1	180 VA	250 VA					1	20 A	3/4"C, 1#12, #12N, #12G	Cabinet Heater	20
2	Receptacle	3/4"C, 1#12, #12N, #12G	20 A	1			360 VA	380 VA			1	20 A	3/4"C, 1#12, #12N, #12G	Lighting	22
23		3/4"C, 1#12, #12N, #12G	20 A	1	}				400 VA	531 VA	1	20 A	3/4"C, 1#12, #12N, #12G	Lighting	24
2!		<del></del>		·····		1500 VA					1	20 A	3/4"C, 1#12, #12N, #12G	Lighting	26
27	,							870 VA			1	20 A	3/4"C, 1#12, #12N, #12G	Lighting	28
29	Lighting	3/4"C, 1#12, #12N, #12G	20 A	1	}				1440 VA	1252 VA	1	20 A	3/4"C, 1#12, #12N, #12G	Lighting	30
·····		<del>wimmunim</del>	To	tal Load:	9450	) VA	8815	5 VA	8043	3 VA					
			Tot	al Amps:	79.	7 A	74.4	4 A	67	A	,				
Load	Classification		Cor	nected L	oad_	De	mand Fac	tor	Estin	nated Den	mand		Panel	Totals	
Equi	oment			400 VA			100.00%			400 VA					
KITC	HEN			8000 VA			100.00%			8000 VA			Total Conn. Load:	26308 VA	
Light	ng			5973 VA			125.00%			7466 VA			Total Est. Demand:		
Moto				2150 VA			100.00%		1	2150 VA			Total Conn. Current:		
	ptacle			9785 VA			100.00%			9785 VA			Total Est. Demand Current:		
000	F		+	3.30 VA			.00.0070			5.55 V/1			. Juli Lou Bomana Juntent.		
	 S:														

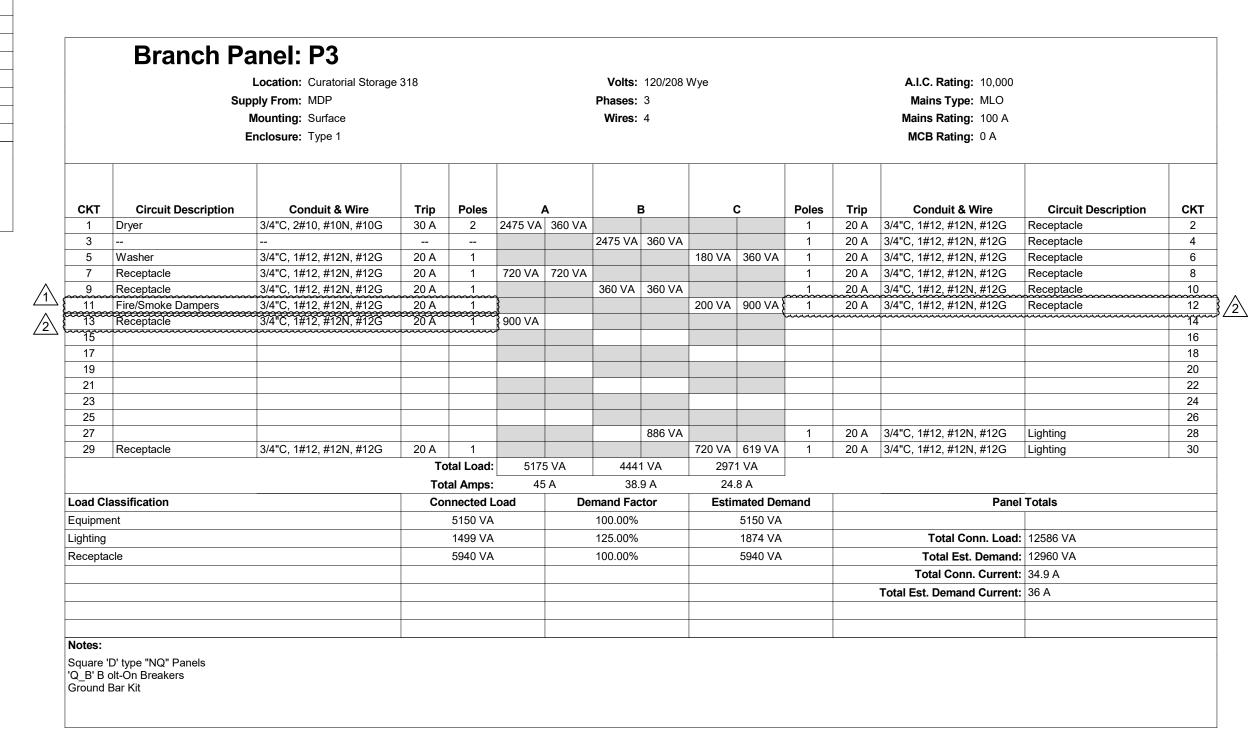

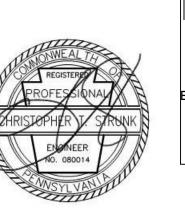

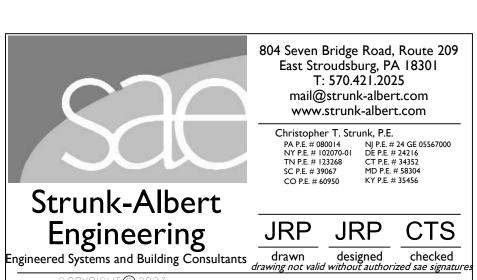

Christopher T. Strunk, P.E.

PA P.E. #080014 NJ P.E. #24 GE 05567000

NY P.E. #102070-01 DE P.E. #24216

TN P.E. #123268 CT P.E. #34352

SC P.E. #39067 MD P.E. #58304

CO P.E. #60950 KY P.E. #35456

© MKSD, LLC www.mksdarchitects.com

**E600** 

architects

Silvia A. Hoffman, AIA, LEED

Todd O. Chambers, AIA, NCARB Jill P. Hewes, AIA, LEED AP

Architecture Interiors

**Project Management** 

Allentown, PA 18104

866.512.MKSD toll free 610.366.2081 phone 610.366.8399 fax

MKSD, LLC 1209 Hausman Road

Suite A

SIGNATURE

Association er Addition

enter

Sounty Historical α λ & Heritage Cent

Monroe Co Alteration

REVISIONS

DRAWING TITLE

SCHEDULES

PROJECT NUMBER 16.200

JRP

01.26.23

DRAWING NUMBER

DRAWN BY

SCALE

DATE

01.26.23 - Issued for Permit

02.07.23 Addendum 1

2 02.16.23 Addendum 2

900

Strunk-Albert Engineering This document is the sole propert and copyright of SAE for the specified project. Reproduction or use without authorization is prohibited.